T.18S.,R.2W.,W.M.

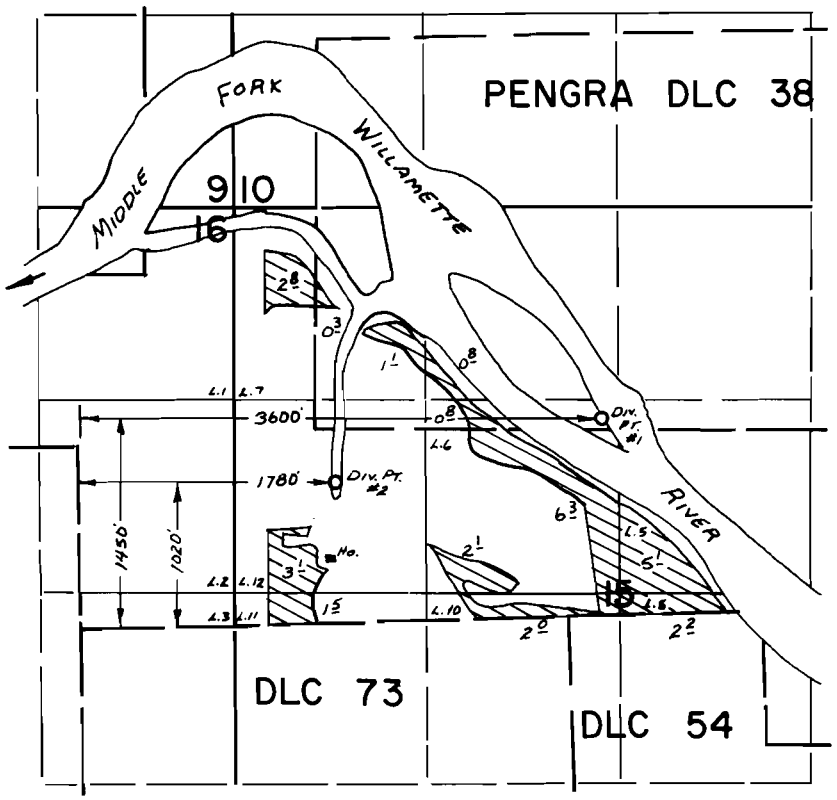

FINAL PROOF SURVEY

UNDER

Application No. 60888 Permit No. 45356

IN NAME OF

LAIRD PIONEER FARM

Surveyed July 7 1982, by L. M. TOLL

Zoom of ASCS Photo