


# T. 7 S., R. 11 W., W.M.

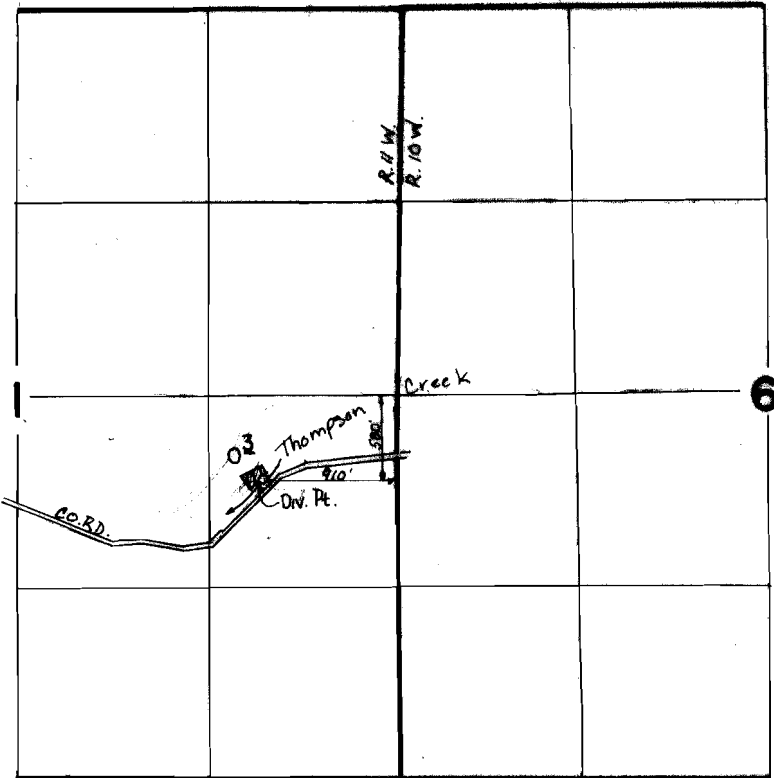

1" = 1320'

## FINAL PROOF SURVEY UNDER

Application No. 61058... Permit No. 45499.....

IN NAME OF

**ALBERT L. & IRENE HUDSON**

Surveyed NOV...1... 1983., by .M...CAHILL.....