


T. 36 & 37 S., R. 4 W., W. M.

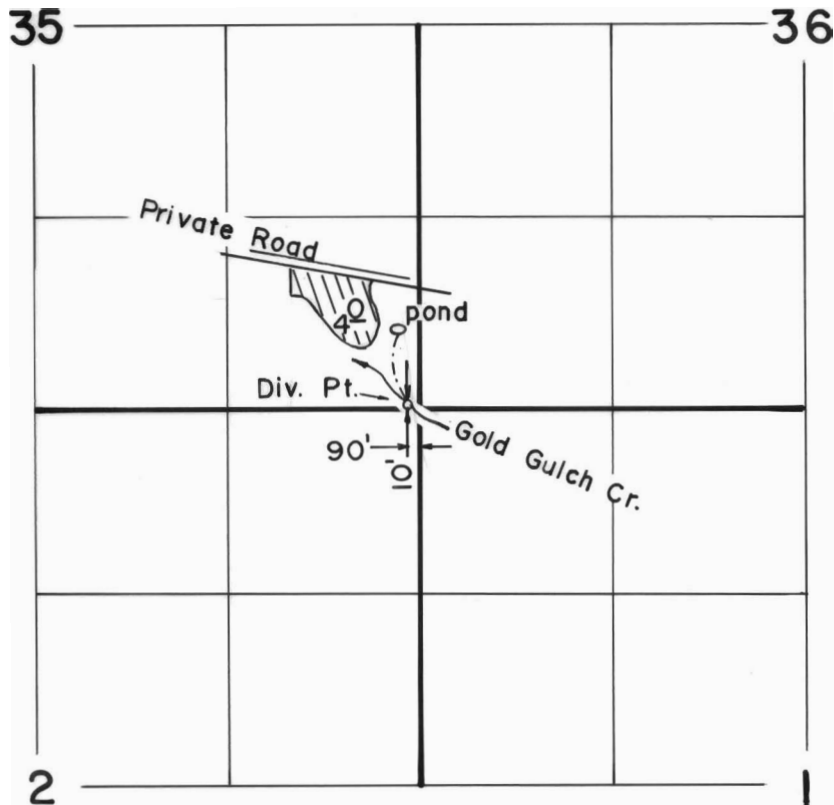

FINAL PROOF SURVEY
 UNDER

Application No. 59462 Permit No. 45531
 IN NAME OF

.....MARKUS.....LACKNER.....

Surveyed JUL...2... 19.86, by B. S. JAMES...