


T. 20 S., R. 4 W., W. M.

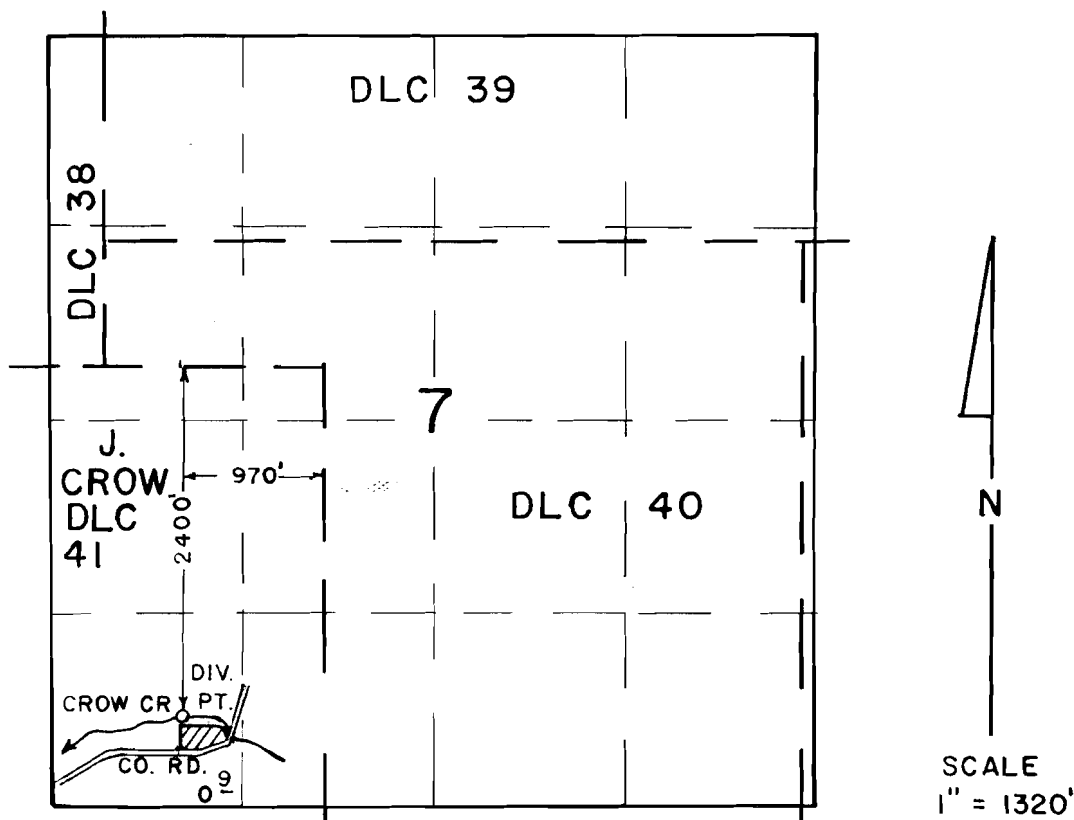

FINAL PROOF SURVEY
UNDER

Application No. 60886.. Permit No. 45554.....
IN NAME OF

WILLIAM E. WENGER

Surveyed SEP. 24 1984, by P. PAGTER.....