


P-45586
C-62070

T.13S.,R.32E.,W.M.

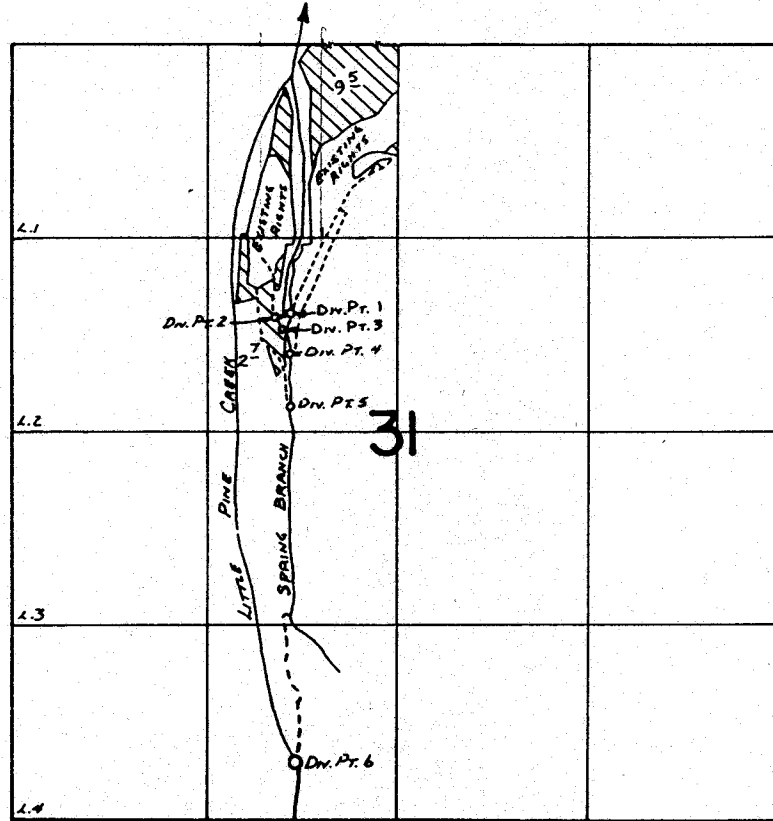

Diversion Point	1-1830 ft. S. & 740 ft. W.	} ALL from N 1/4 Cor. Sec. 31
	2-1830 ft. S. & 840 ft. W.	
	3-1930 ft. S. & 800 ft. W.	
	4-2110 ft. S. & 740 ft. W.	
	5-2460 ft. S. & 740 ft. W.	
	6-4880 ft. S. & 700 ft. W.	

FINAL PROOF SURVEY
UNDER

Application No. ..60274.. Permit No. ...45586.....
IN NAME OF

.....ALVA & HELEN CONLEE.....

Surveyed June..22.. 19.83., by ..R.W..Cettel.....