


T. 36 S., R. 4 W., W.M.

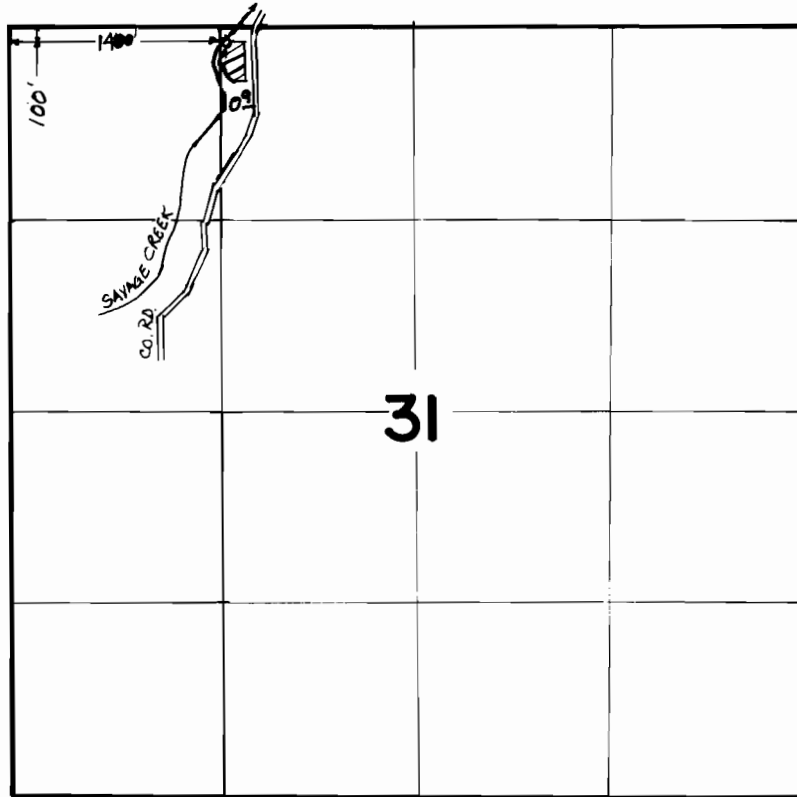

**FINAL PROOF SURVEY**  
UNDER

Application No. 60400 Permit No. 45599  
IN NAME OF

**CHRISTOPHER LEO KEARNS**

Surveyed JUNE 13, 1983, by B. S. JAMES