


T. 36 S., R. 1 E., W. M.

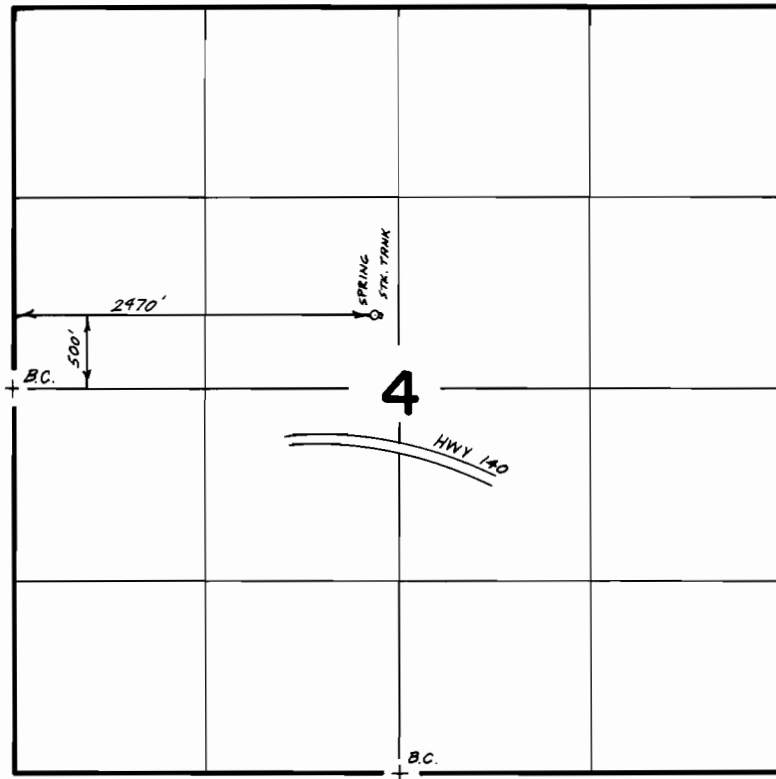

SCALE 1" = 1320'

FINAL PROOF SURVEY UNDER

Application No. 61223..... Permit No. 45600.....
IN NAME OF

.....GERALD W. HANSEN.....

Surveyed JUNE 12... 1984., by B.S. JAMES.....