


T.26S.,R.5W.,W.M.

Section 30

NW 1/4 NW 1/4

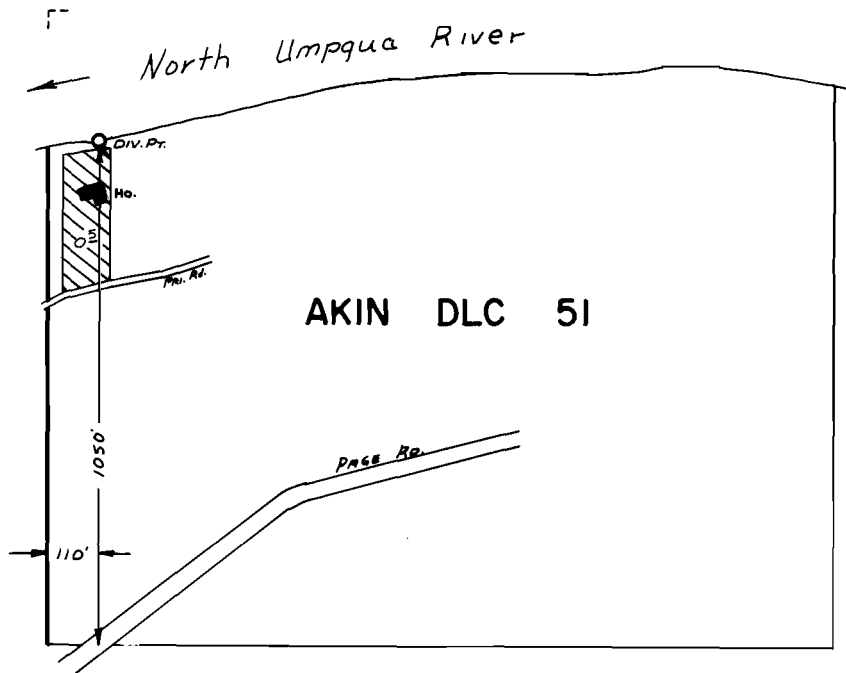

SCALE: 1" = 400'

FINAL PROOF SURVEY
UNDER

Application No. 61442 Permit No. 45661.....
IN NAME OF

.....MARCUS W. BROWN.....

Surveyed Aug. 9 1982, by L.M. TOLL.....