


T. 15 S. R. 5 W. W. M.

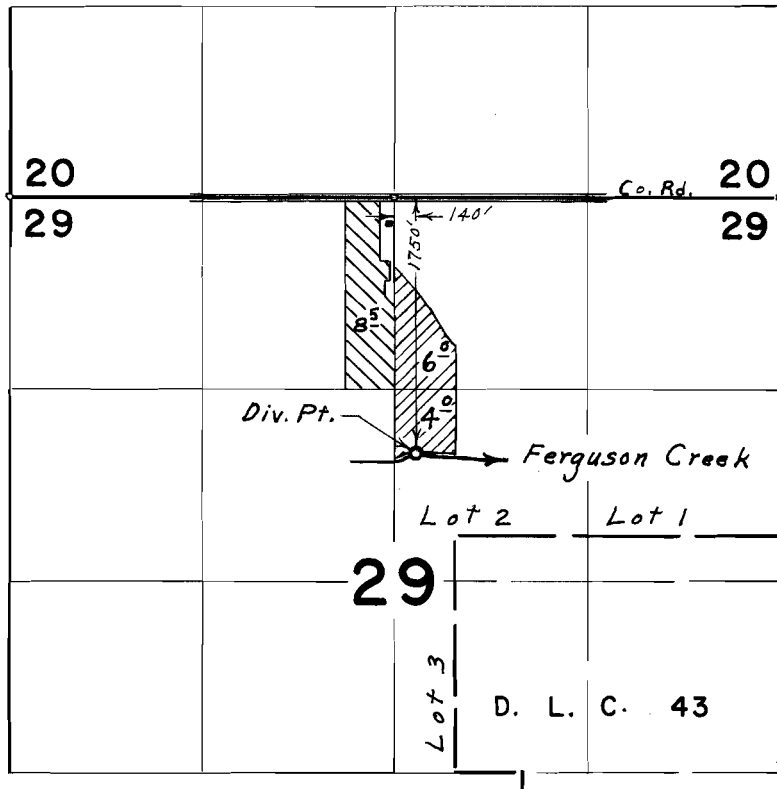

FINAL PROOF SURVEY
UNDER

Application No. 61547 45787
43896 Permit No. 32812 
IN NAME OF

HENRY M. & VERA M. MOFFETT

Surveyed Aug. 28, 1970, by L. E. Gould
Sept. 17, 1981, S. C. BROWN