


P-45795
C-62078

T.8S.,R.27E.,W.M.

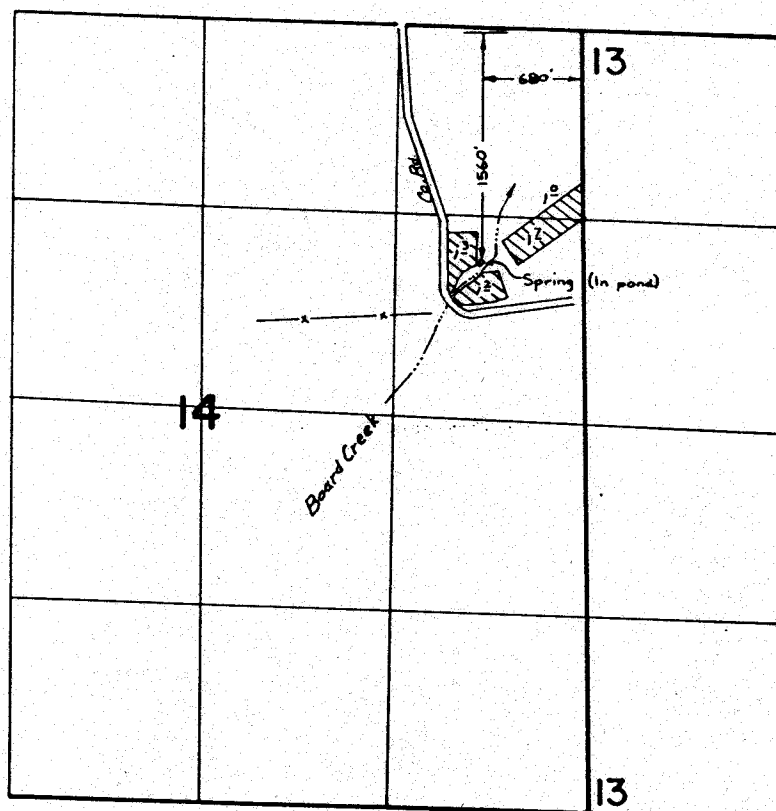

FINAL PROOF SURVEY
UNDER

Application No. 61599... Permit No. 45795.....
IN NAME OF

STANLEY MUSGRAVE

Surveyed Oct. 2, 1982, by S.C. BROWN.....