


# T. 26S., R. 13W., W.M.

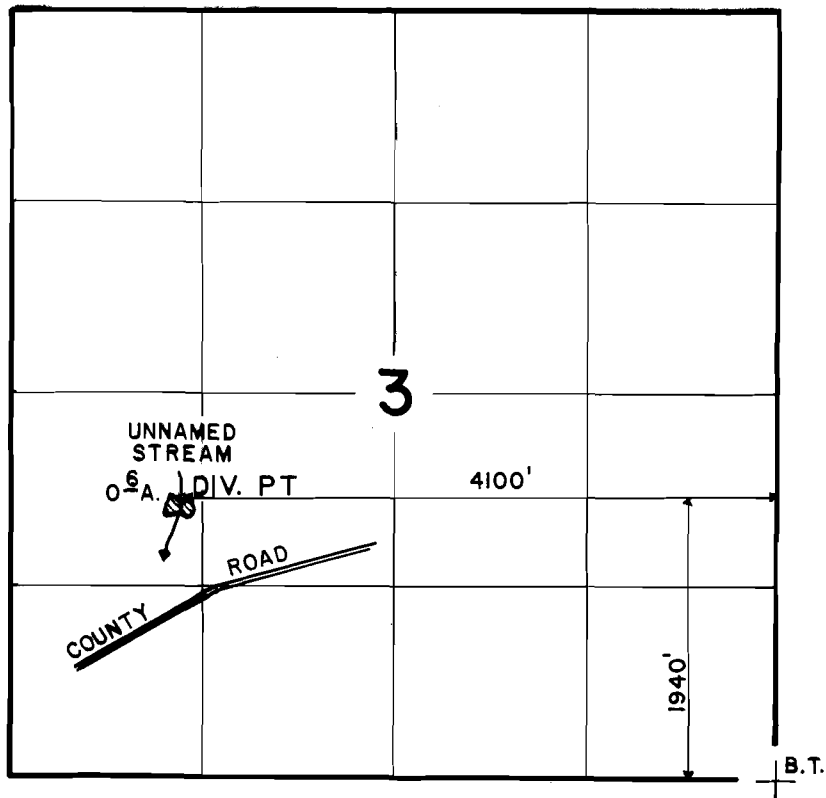

SCALE: 4" = 1 MILE

## FINAL PROOF SURVEY UNDER

Application No. 61729 Permit No. 45819  
IN NAME OF

HOWARD & DOROTHY HAGAN

Surveyed JULY 31, 1986, by J. M. SCHMORDE