



T. 37 S., R. 6 W., W.M.

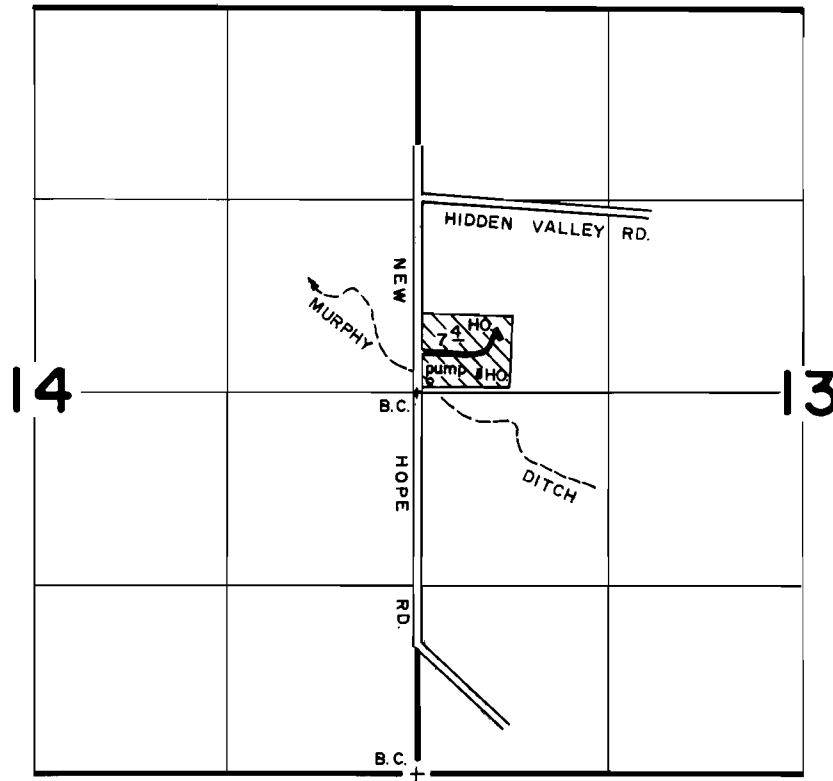

T. 37 S., R. 5 W., W.M.

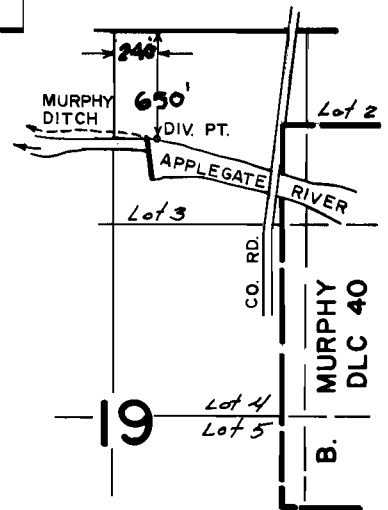

**FINAL PROOF SURVEY**  
UNDER

Application No. 61493. Permit No. 45844...  
IN NAME OF

LOUIS L. MURPHY & H.E. RAMEY

Surveyed OCT. 4 19.83, by B. S. JAMES

SCALE: 4" = 1 MILE