


T. 36 S., R. 4 W., W. M.

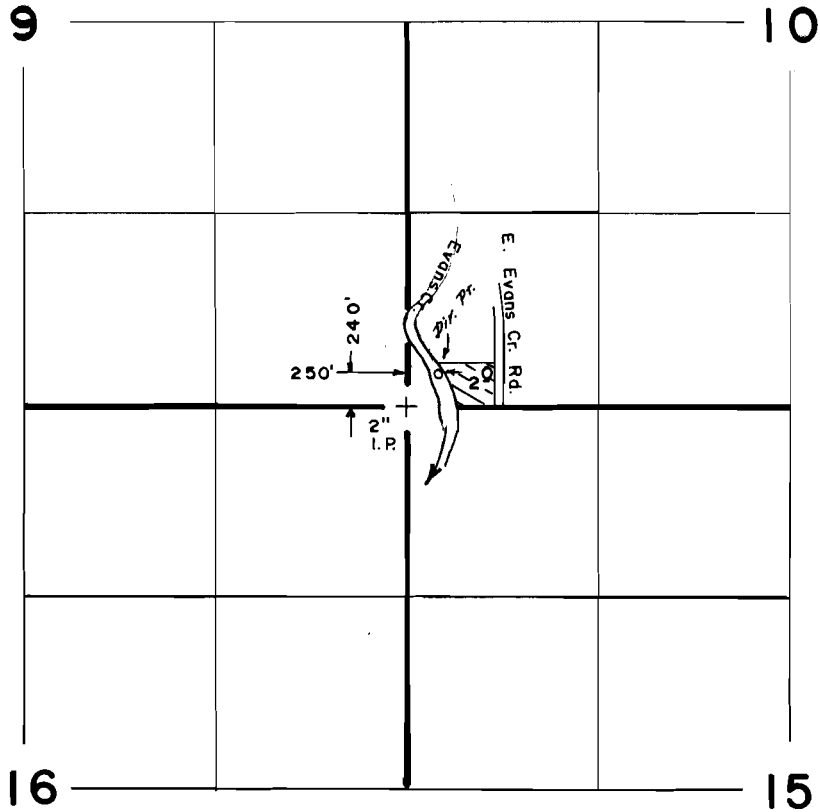

Scale: 1" = 1320'

**FINAL PROOF SURVEY**  
UNDER

Application No. 61669 Permit No. 46011  
IN NAME OF

OSCAR F. DURON & JOSIE C. DURON

Surveyed OCT. 13. 1986, by B. S. JAMES