


# T17S. RIW. WM.

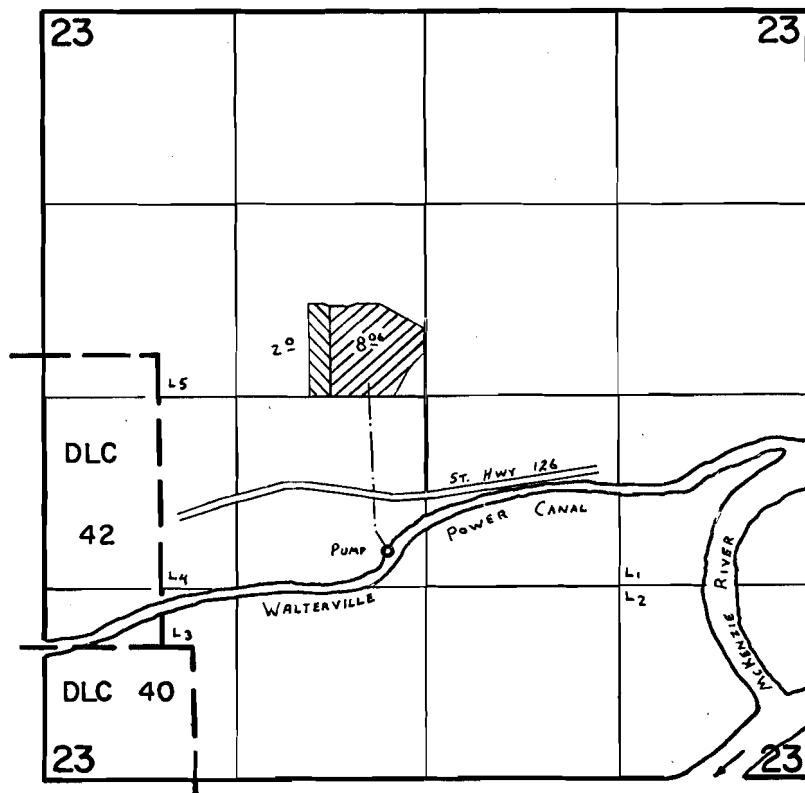

PUMP Loc: 1070'S ± 260' W. fr. CENTER SEC. 23.

## FINAL PROOF SURVEY UNDER

Application No. 61893 52540 Permit No. 46266 37748   
IN NAME OF

MICHAEL L. FOUNTAIN

Surveyed JULY 18 1978 by C. L. HUGHES  
Aug 3 1982 L. M. TOLL