


T. 30 S. R. 5 W

NE SW S. 27

1" = 100'

Comp
5/2/81

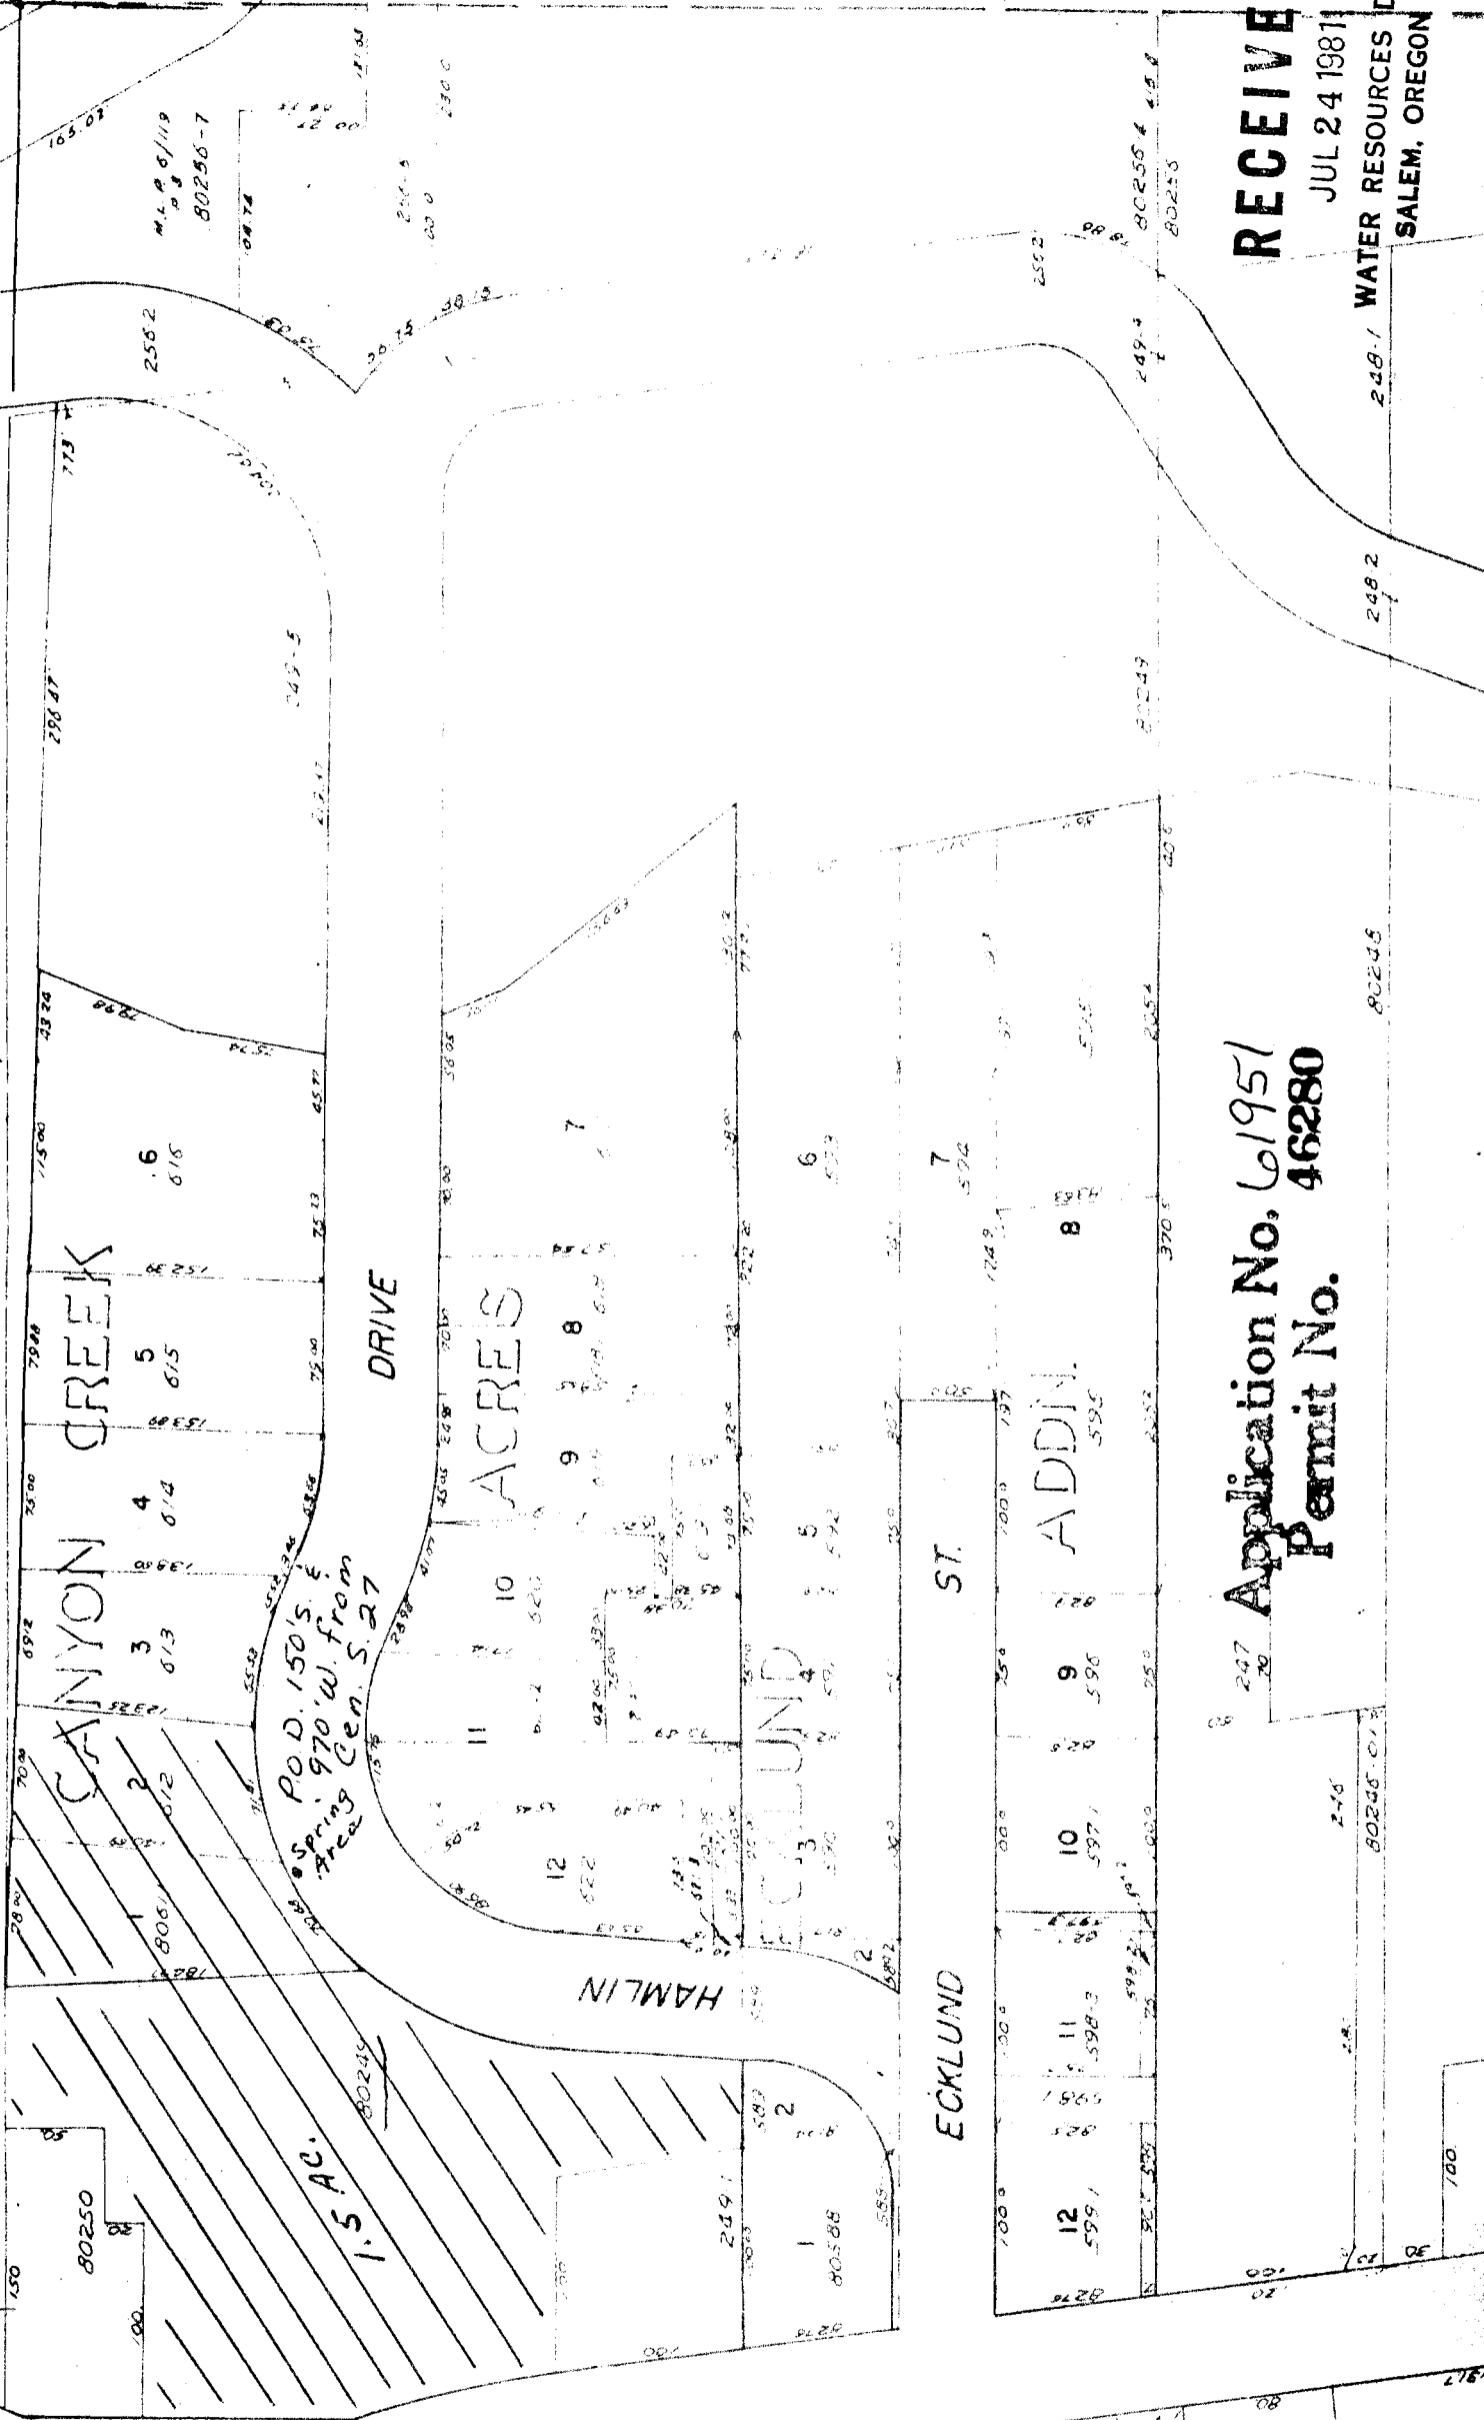

Application No. 61951
 Permit No. 46280

RECEIVED
 JUL 24 1981
 WATER RESOURCES DEPT
 SALEM, OREGON