




T. 23 S., R. 12 W., W.M.

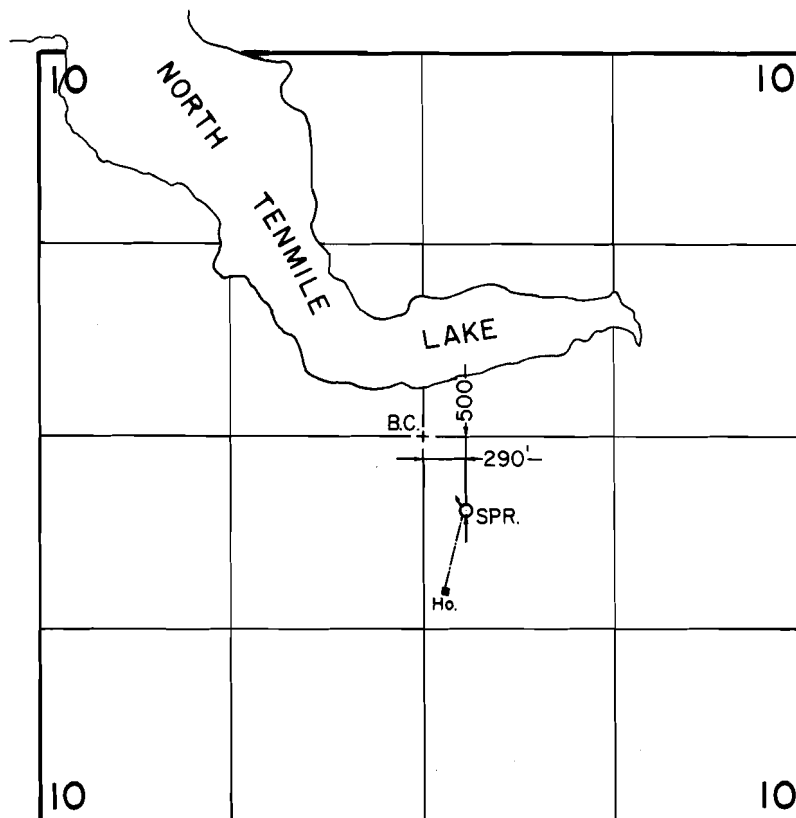

SCALE: 1" = 1320'

FINAL PROOF SURVEY UNDER

Application No. 62184 Permit No. 46388
IN NAME OF

JUDY McDOLLE

Surveyed SEPT. 18, 1988, by T. M. WARREN