


T. 30 S., R. 4 W., W.M.

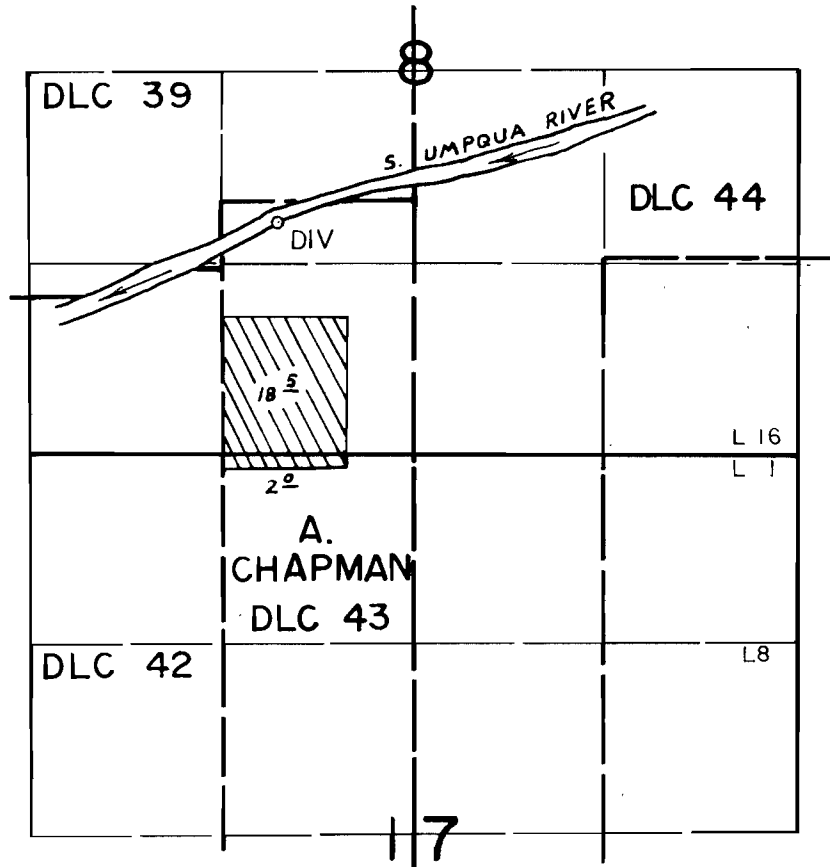

DIV. PT. LOC. 150'S. & 930'W FROM NE COR. DLC 43

SCALE: 4" = 1 mile

**FINAL PROOF SURVEY**  
UNDER

Application No. 62827 Permit No. 46763  
IN NAME OF

GEORGE V. HUMPHREYS

Surveyed AUG. 23. 1983. by J. S. DONALDSON