
T. 27S., R. 6 W., W. M.

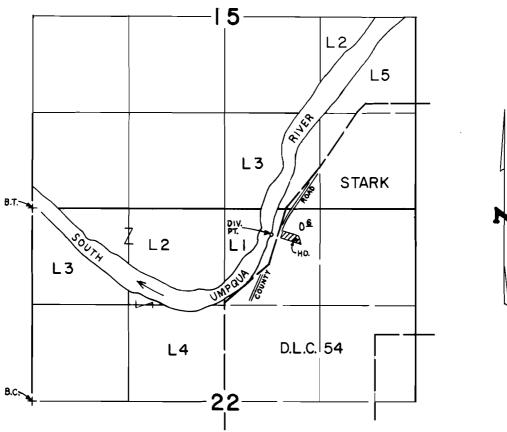

DIV. PT. LOCATED 350'S. & 1,980' W. FROM N.E. COR. SEC. 22

SCALE: 4"= I mile

FINAL PROOF SURVEY

Application No. 63720.. Permit No. 46900.....

RAYMOND O. & HAZEL I. OLSON

Surveyed MAY...9. 1984., by ...L...CASHLON...