


T.1N. R.15 E. W.M.

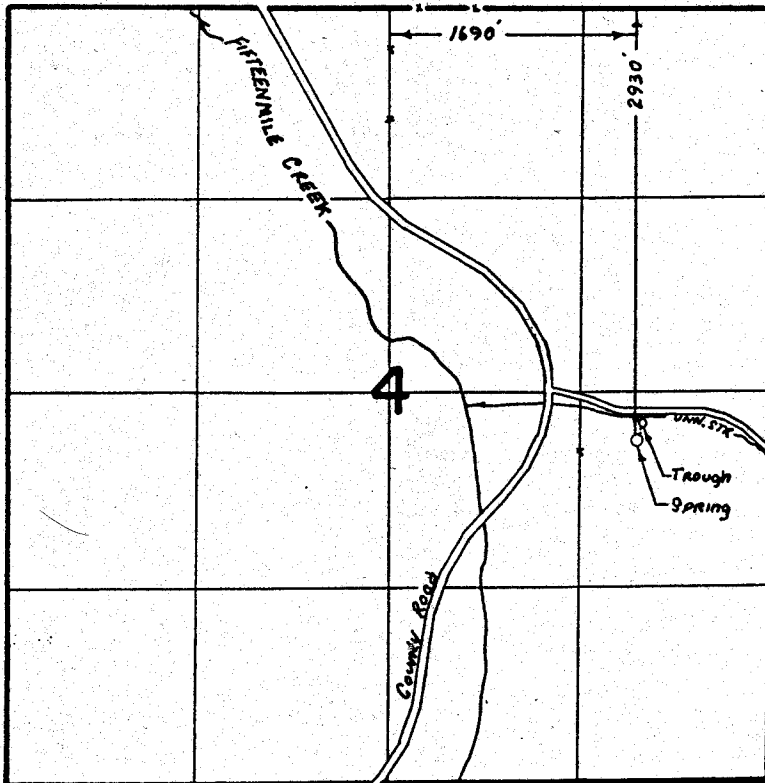

FINAL PROOF SURVEY UNDER

Application No. 63969... Permit No. 47061...
IN NAME OF

DAN C. & NELDA M. PETROFF

Surveyed May 20, 1983, by T. J. Paul