


R 47143
62099

T. 9S., R. 21E., W. M.

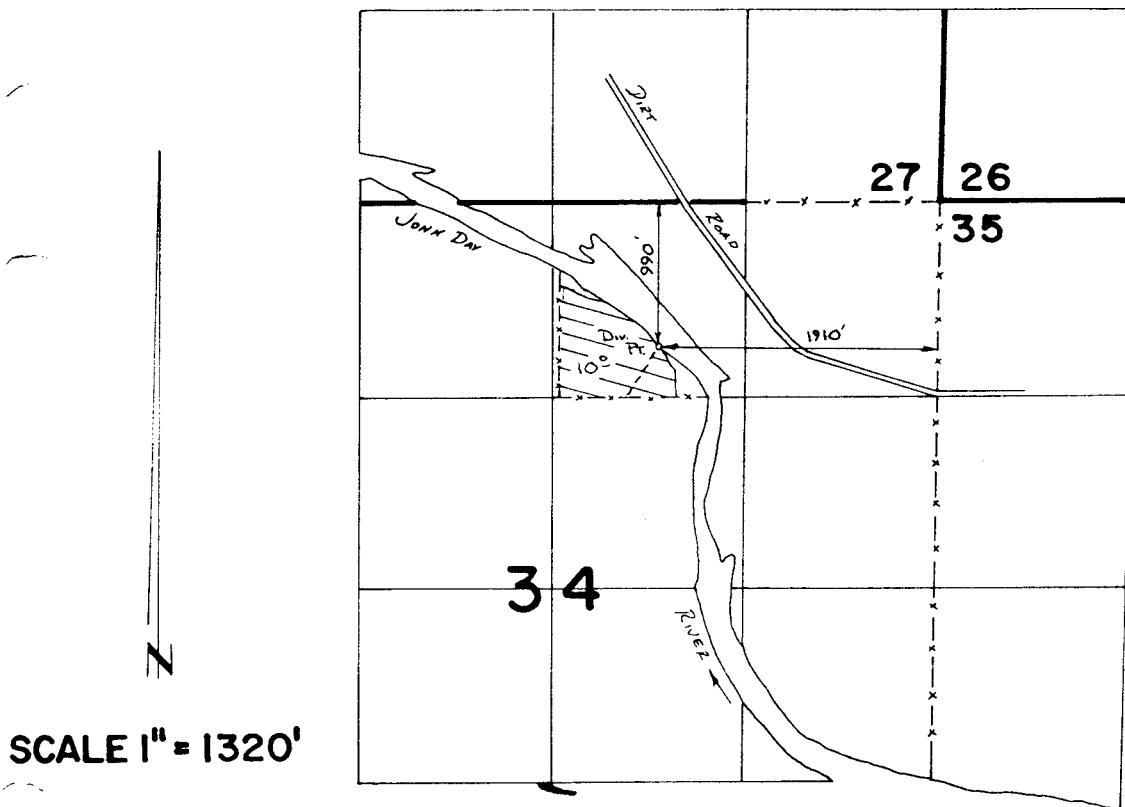

FINAL PROOF SURVEY
UNDER

Application No. **64425** Permit No. **47143**
IN NAME OF

JAMES WEAVER

Surveyed 4-21 1986, by V.L. Church