
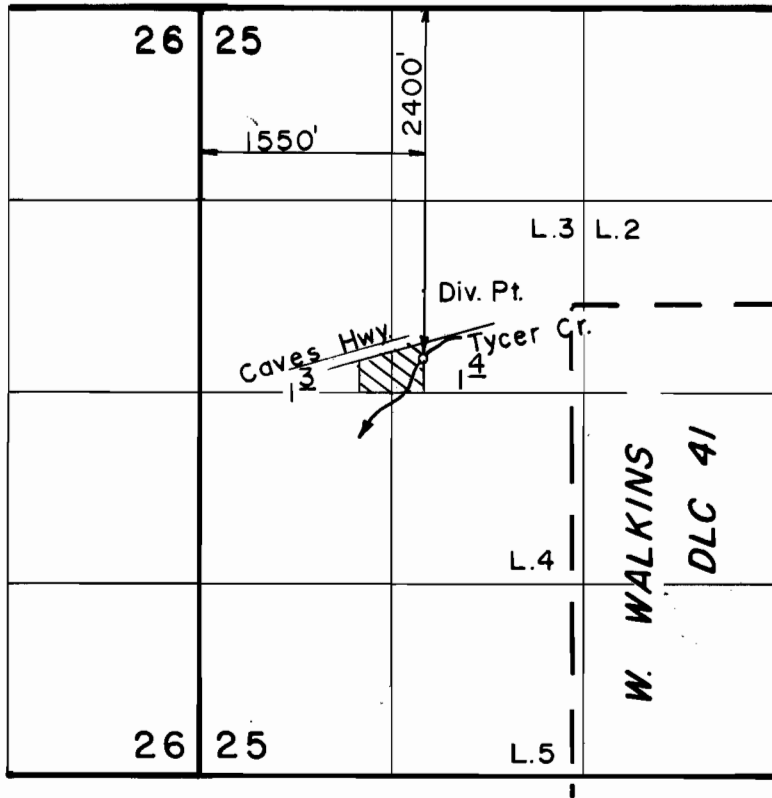


T. 39 S., R. 8 W., W. M.

 

Scale: 1" = 1320'

FINAL PROOF SURVEY UNDER

Application No. ~~6.4.481~~ Permit No. ~~4.7.1.7.8...~~
IN NAME OF

.....EARLY K. ELMORE.....

Surveyed May 14, 1986, by B. S. JAMES.