
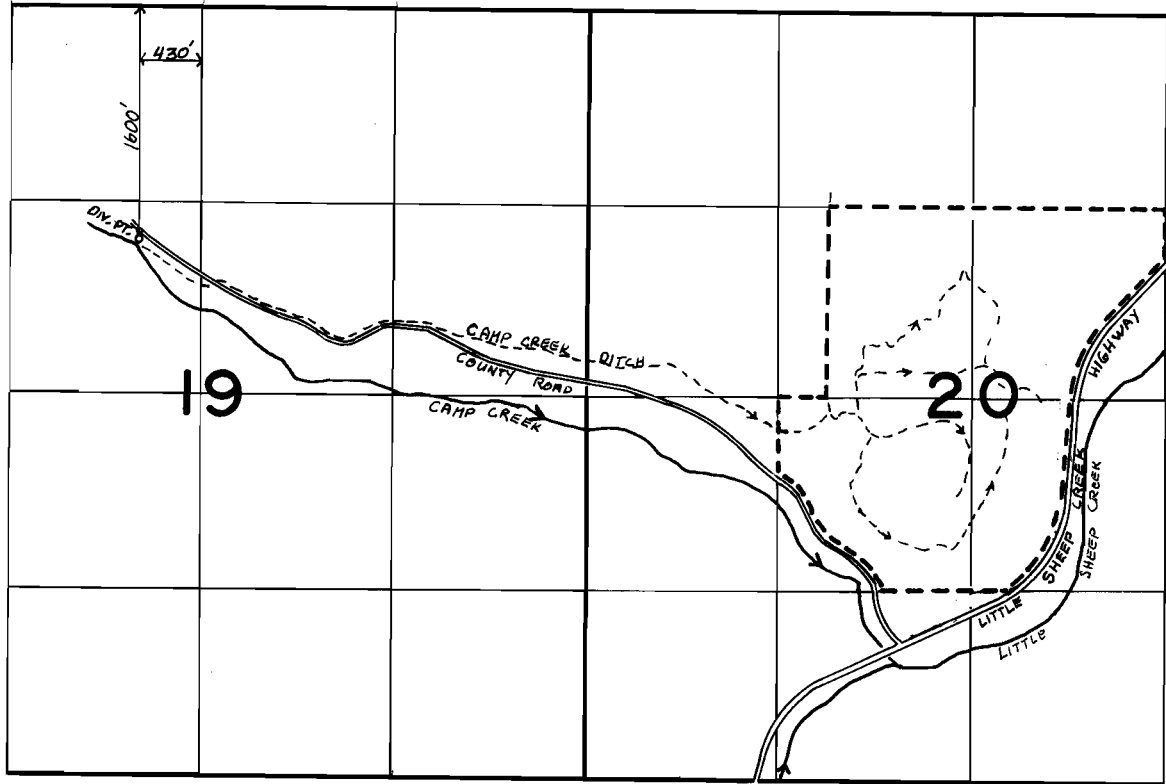


T.1N., R. 48E., W.M.

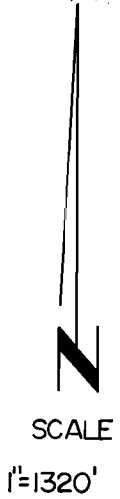

FINAL PROOF SURVEY UNDER

Application No. 61185..... Permit No. 47245.....
IN NAME OF

A. L. DUCKETT

Surveyed Aug. 7..... 1985, by V. L. CHURCH.....