


T. 32 S., R. 4 W., W.M.

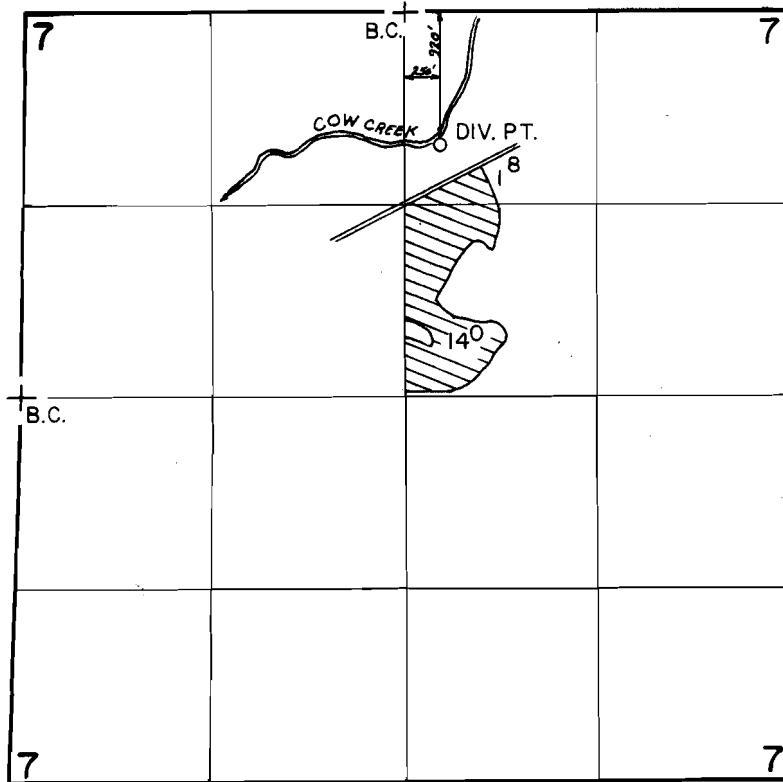

SCALE: 1" = 1320'

FINAL PROOF SURVEY
UNDER

Application No. 63615..... Permit No. 47255.....
IN NAME OF

.....**EVERETT O. WORLEY**.....

Surveyed NOV. 21 1983, by L. E. CASHION.....