


T. 39 & 40 S., R. 8 W., W.M.

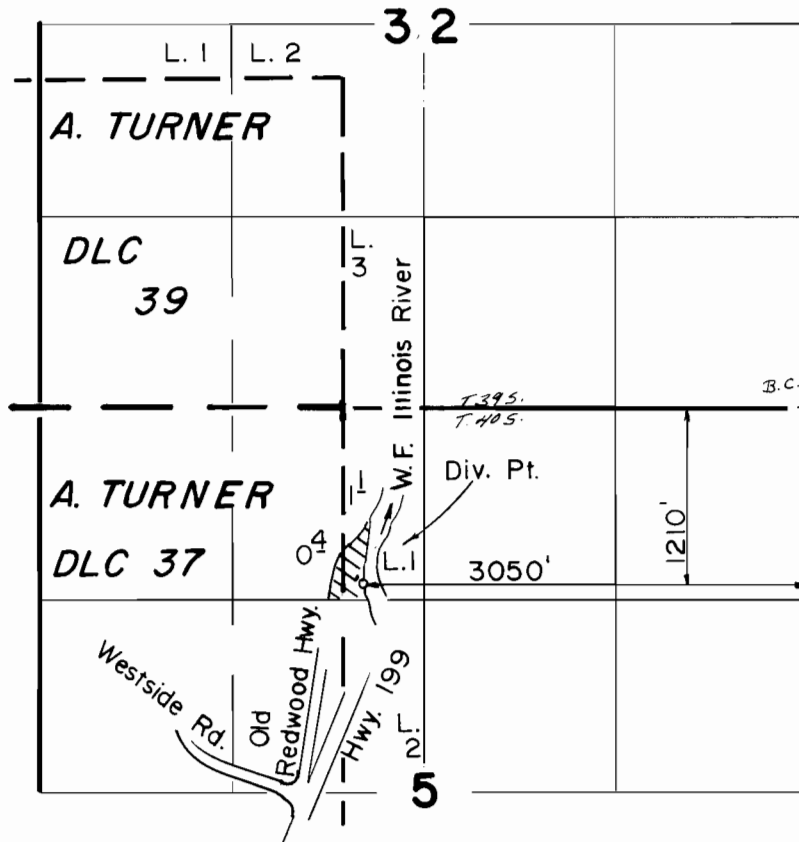

Scale: 1" = 1320'

FINAL PROOF SURVEY
UNDER

Application No. 64560 Permit No. 47331
IN NAME OF

JAMES L. FRICK

Surveyed MAY 7 1986, by B. S. JAMES.