


T.39S.,R.8W.,W.M.

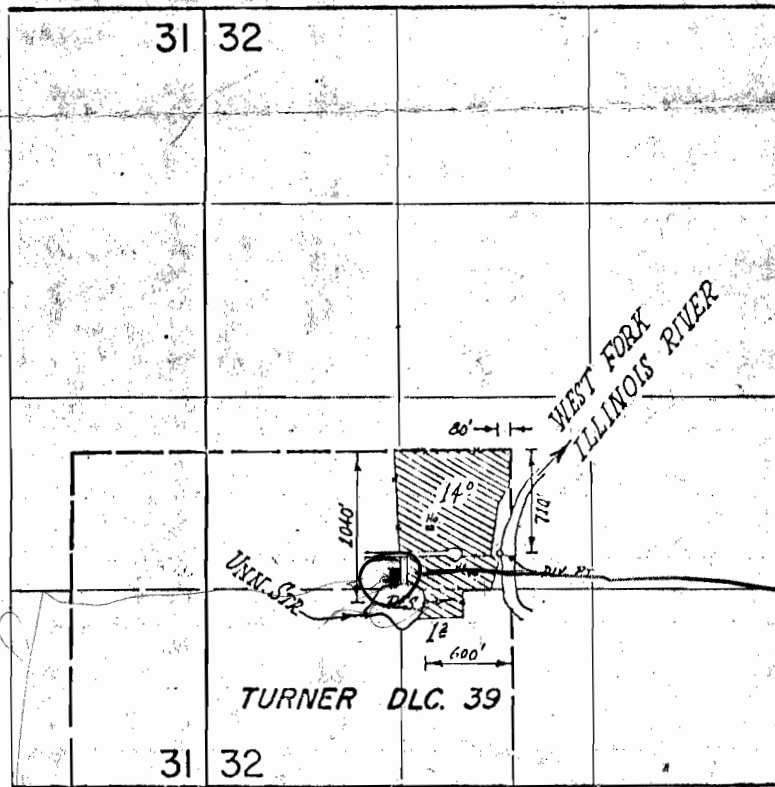

Application No. 64774  
Permit No. 17521

**RECEIVED**

JAN 21 1983

WATER RESOURCES DEPT.  
SALEM, OREGON

**RECEIVED**

FEB 16 1983

WATER RESOURCES DEPT.  
SALEM, OREGON