


T. 26 S., R. 4 W., W.M.
SECTION 21

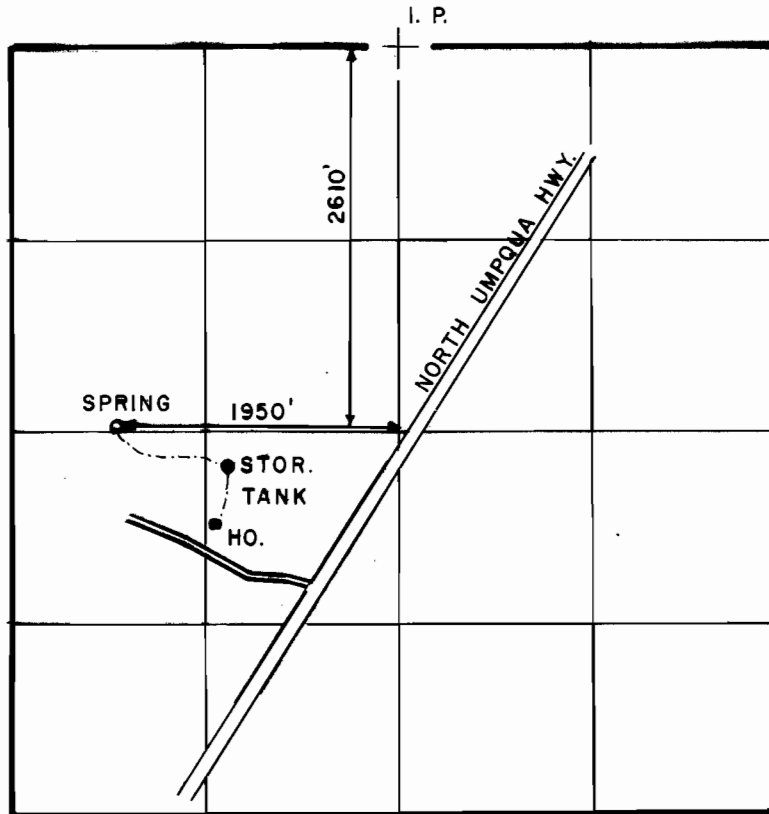

SCALE: 4" = 1 MILE

FINAL PROOF SURVEY
UNDER

Application No. ..68945. Permit No. ...49965...
IN NAME OF

GEORGE G. ROONEY AND VIVIAN M. ROONEY

Surveyed SEPT. 28 19.88, by ..J.M. SCHMORDE.