


T.13S., R.1W., W. M.

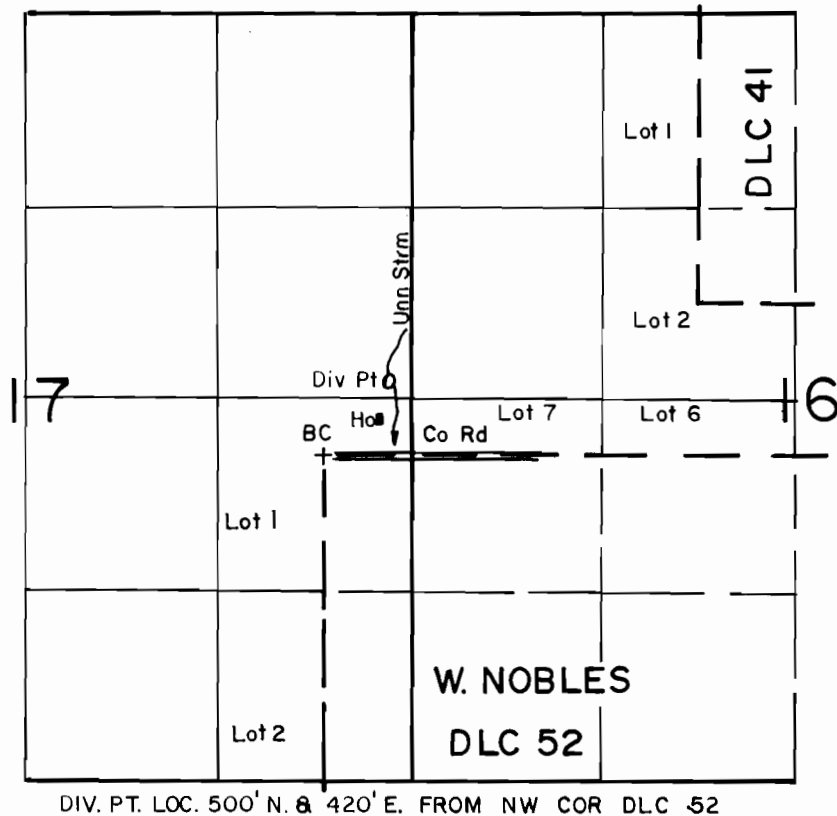

DIV. PT. LOC. 500' N. & 420' E. FROM NW COR DLC 52

SCALE: 1" = 1320'

FINAL PROOF SURVEY UNDER

Application No. 25109... Permit No. 20498.....
IN NAME OF

DIANA D. & GORDON E. OLSON.....

Surveyed JUNE 29, 1989, by T.M. WARREN.....