


T. 39 S., R. 5 W., W.M.

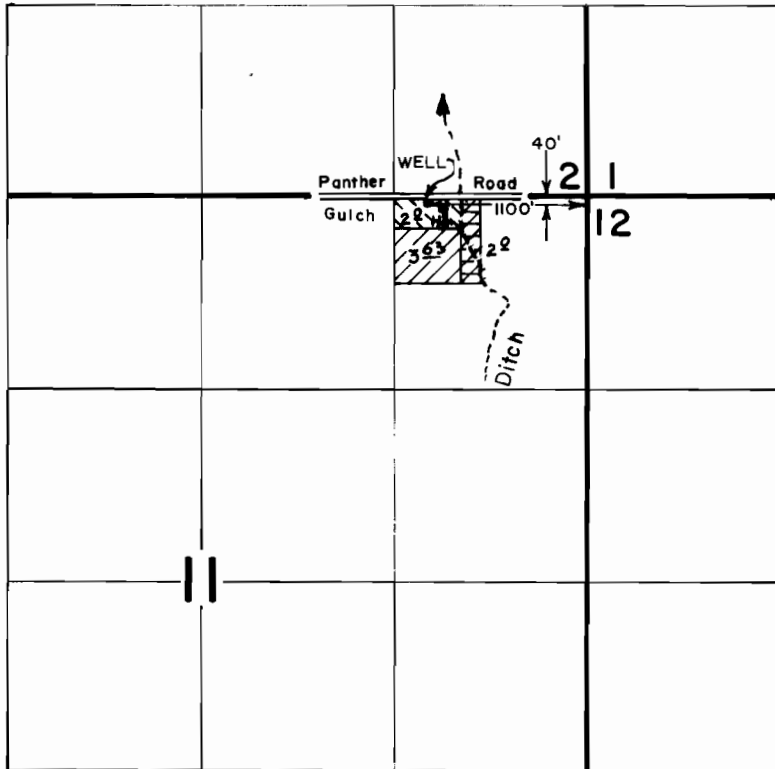




FINAL PROOF SURVEY
UNDER

TRANSFER NO. 4741
Application No. G-10270 Permit No. G-9362
IN NAME OF

..... **FAYE M. RIGEL**

Surveyed **AUG. 11** 1983, by **B. S. JAMES**

SCALE: 4" = 1 MILE

-  PRIMARY
-  SUPPLEMENTAL
-  PRIMARY TR. NO. 4741