


T. 4 S., R. 1 W., W.M.

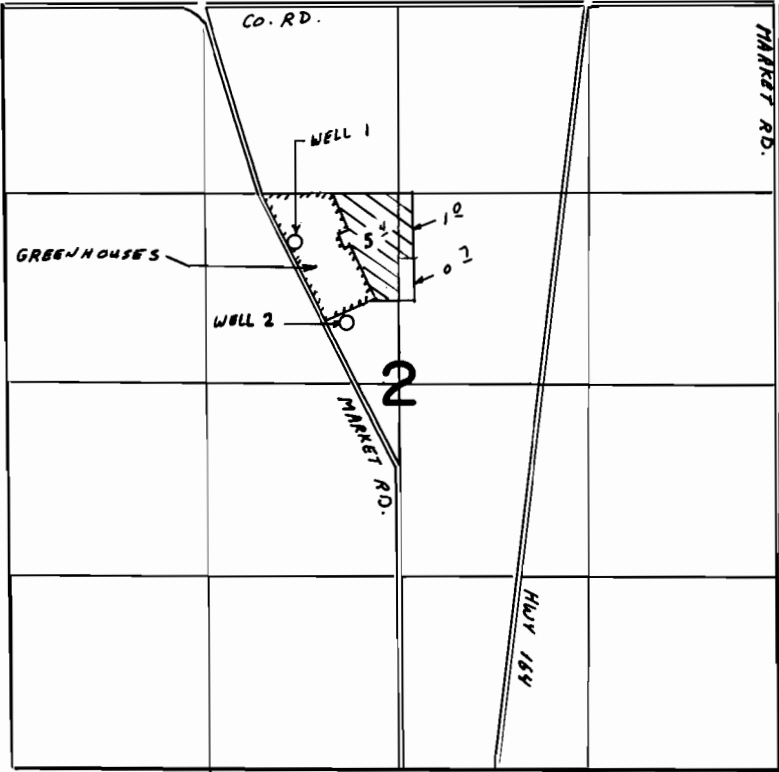

WELL 1: 1640' S AND 700' W FROM N 1/4 CORNER SEC. 2

WELL 2: 2170' S AND 360' W FROM N 1/4 CORNER SEC. 2

SCALE 1" = 1320'

FINAL PROOF SURVEY
UNDER

Application No. G-11178 Permit No. G-10389
IN NAME OF

BRAD SHEPHARD

Surveyed APRIL 15 1988, by Z. SALEH

PTS ON 41047-278-117L
5-22-89 Z.F.S.