T.7S. R.1W. W.M

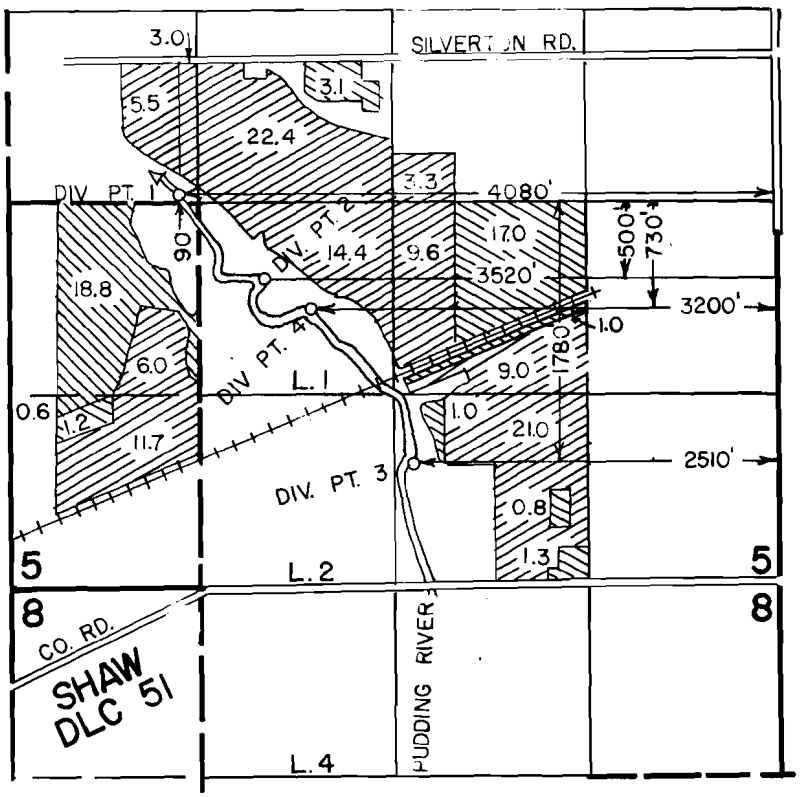

PRIMARY PERMIT 29752 | SUPPLEMENTAL PERMIT 29752 | PERMIT 34818

SCALE 1" = 1320'

N

FINAL PROOF SURVEY

UNDER

R-40094 R-3984
40095 29752
Application No. 46591 Permit No. 34818

IN NAME OF

D. K. K. F. B. DAM

Surveyed SEP. 6 1979, by C.R. RODRIGUEZ

