


T. 9S., R. 5W., W.M.

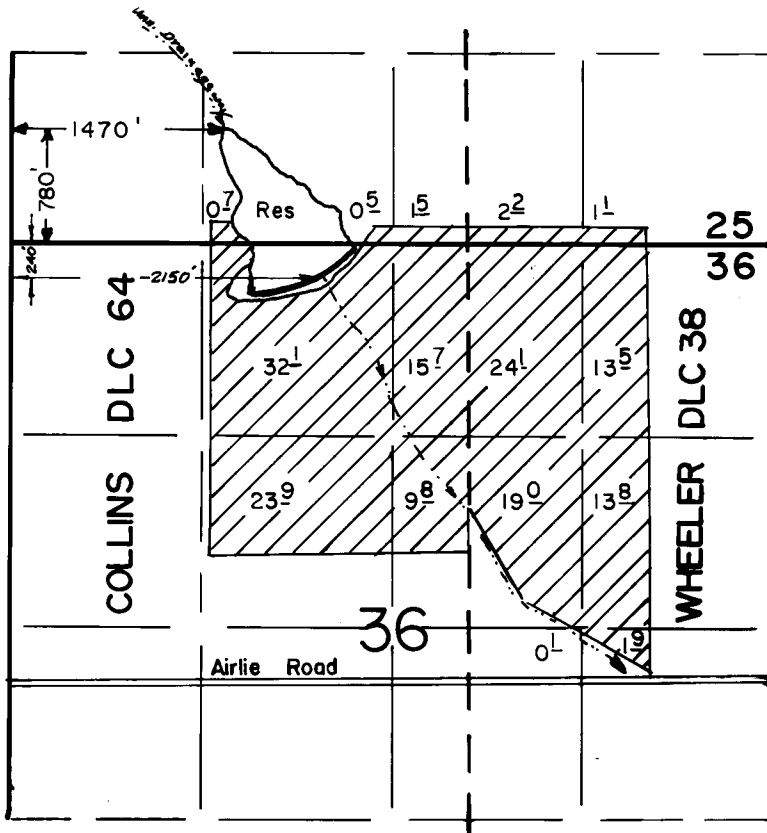

SCALE: 1" = 1320'

**FINAL PROOF SURVEY**  
UNDER

R-54482                      R- 6480  
Application No. 54483..... Permit No. 40594.....  
IN NAME OF

.....**EARL KENNEL**.....

Surveyed AUG. 16... 1984... by J. WOODRUFF.....  
JUNE 3 1987                      B W BISHOP