


T. 38 S., R. 8 W., W.M.

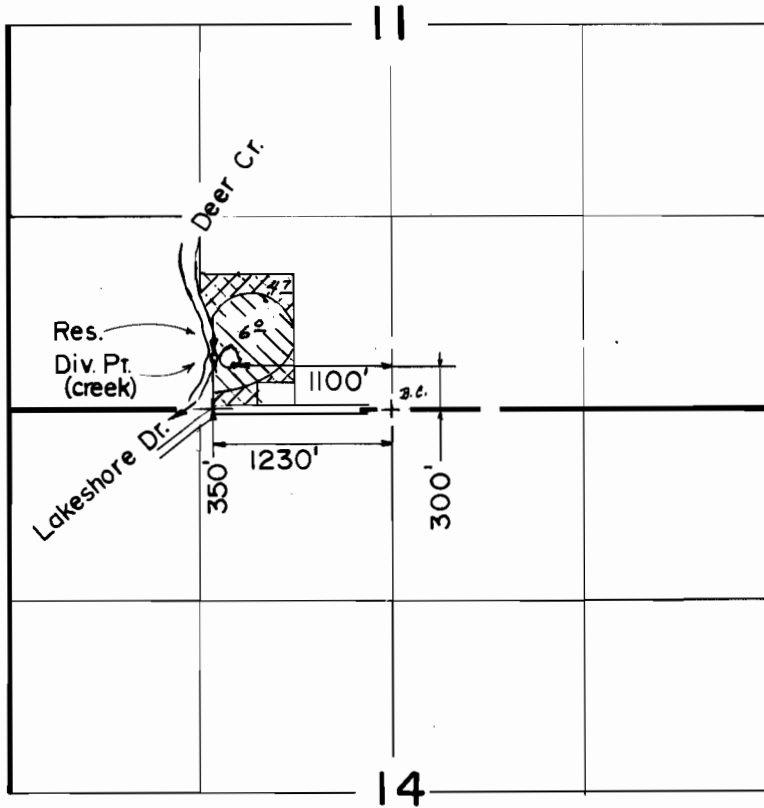

Scale: 1" = 1320'

Primary



Supplemental



### FINAL PROOF SURVEY

UNDER

R-57539

R-7706

Application No. 57540 Permit No. 43539

IN NAME OF

AARON J. SCHEER

Surveyed JUN. 9 1986, by B. S. JAMES