


T. 38 S., R. 8 W., W.M.

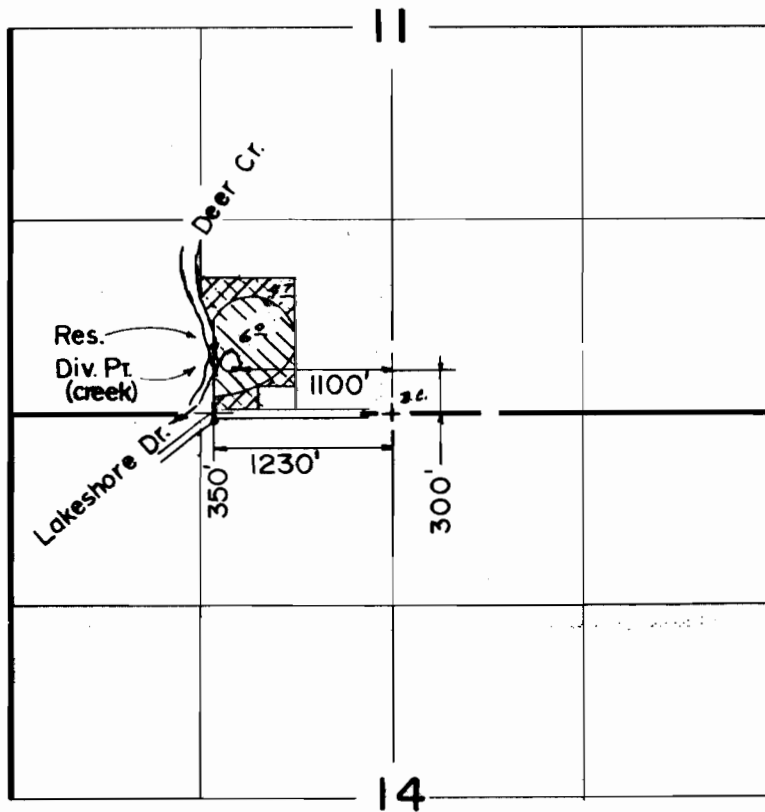

Scale: 1" = 1320'

Primary



Supplemental



FINAL PROOF SURVEY
UNDER

R-57539

R-7706

Application No. 57540 Permit No. 43539...
IN NAME OF

.....AARON J. SCHEER.....

Surveyed JUN. 9. 1986, by B. S. JAMES.