
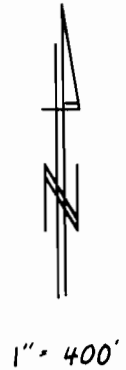


T2S, R6E, WM SECTION 27

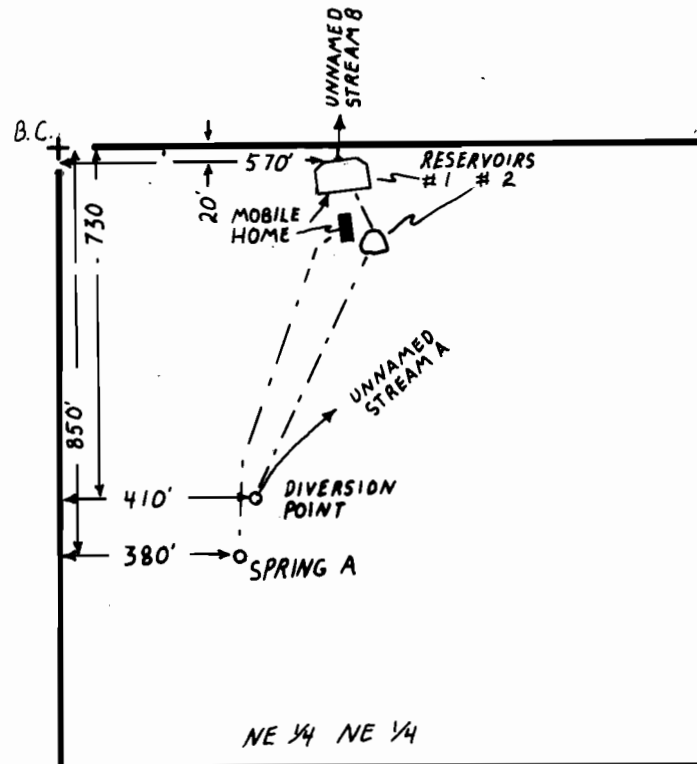

FINAL PROOF SURVEY UNDER

58126 43871
Application No. R-58233 Permit No. R-7788.....
IN NAME OF

.....MERLE ANDERSON.....

Surveyed JULY 30, 1987, by T. M. WARREN..