


T.19 S., R.1&2W., W.M.

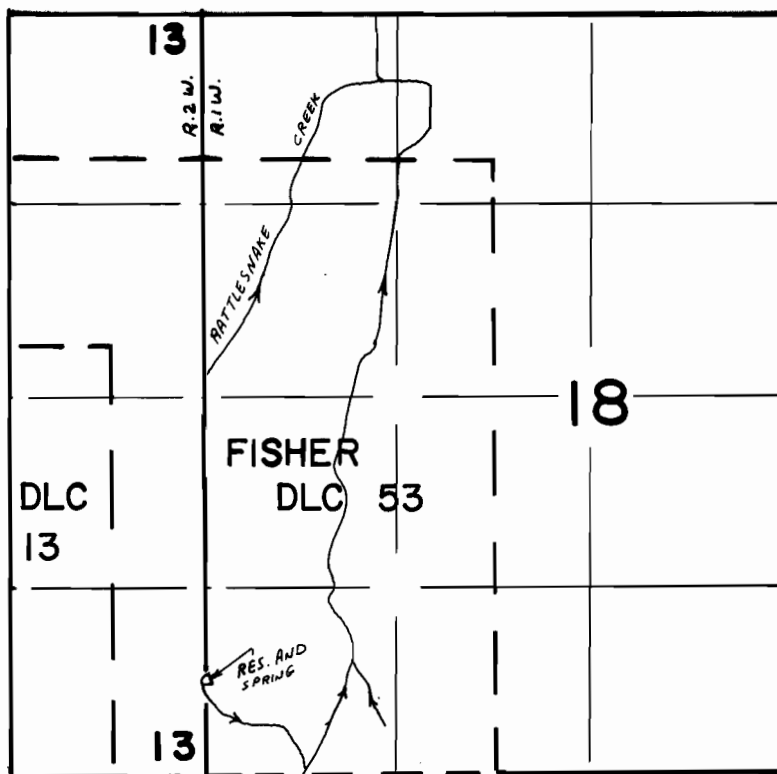

N

SCALE 1" = 1320'

FINAL PROOF SURVEY
UNDER

Application No. R-64540 Permit No. R-8605

IN NAME OF

HILTON H. PAULMAN

Surveyed MAY 24 1988 by Z. SALEH

DBQ-54-57
5-2-89 J.F.S.