


T.I.S.R.I.W.W.M.

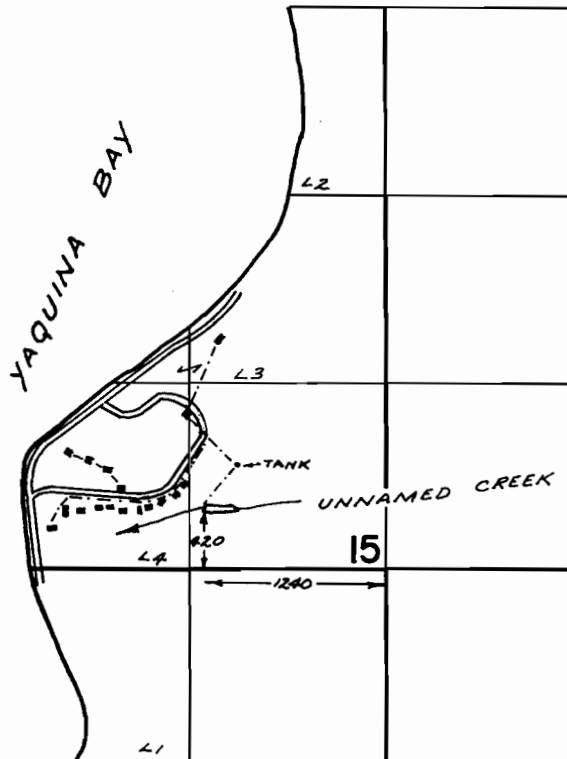

FINAL PROOF SURVEY
UNDER

Application No. R-43957 42128 Permit No. R-4977 32368
IN NAME OF

BAY HILLS WATER IMPROVEMENT DIST. INC.

Surveyed SEPT. 17, 1973, by R. MUCKEN.