


T.I.S., R.II W., W.M.

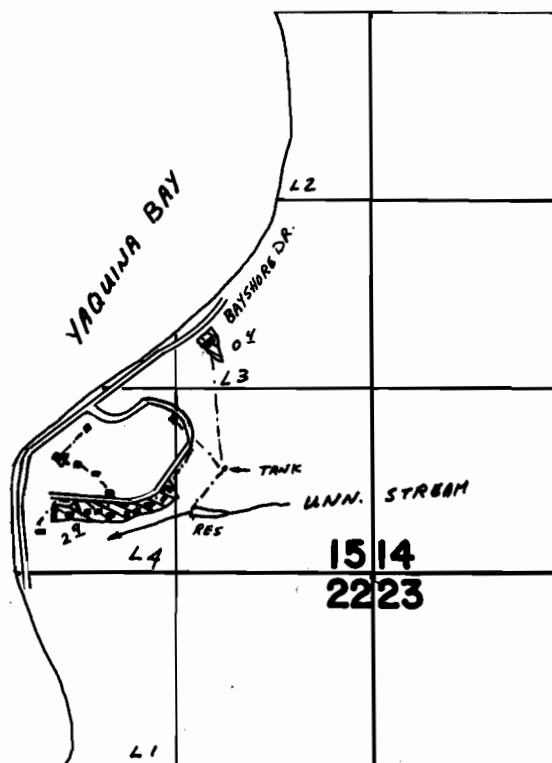

2411: 420' NORTH AND 1240' WEST FROM SE CORNER SECTION 15

SCALE 1" = 1320'

FINAL PROOF SURVEY

UNDER

R-65170

R-9395

Application No. 65171 Permit No. 48267

IN NAME OF

BAY HILLS WATER ASSOCIATION

Surveyed JUL 25 1988, by Z. SALEH

41041-172-117
1-31-89 Z.F.S.