


T. 6S., R. 41E., W.M. SEC. 24

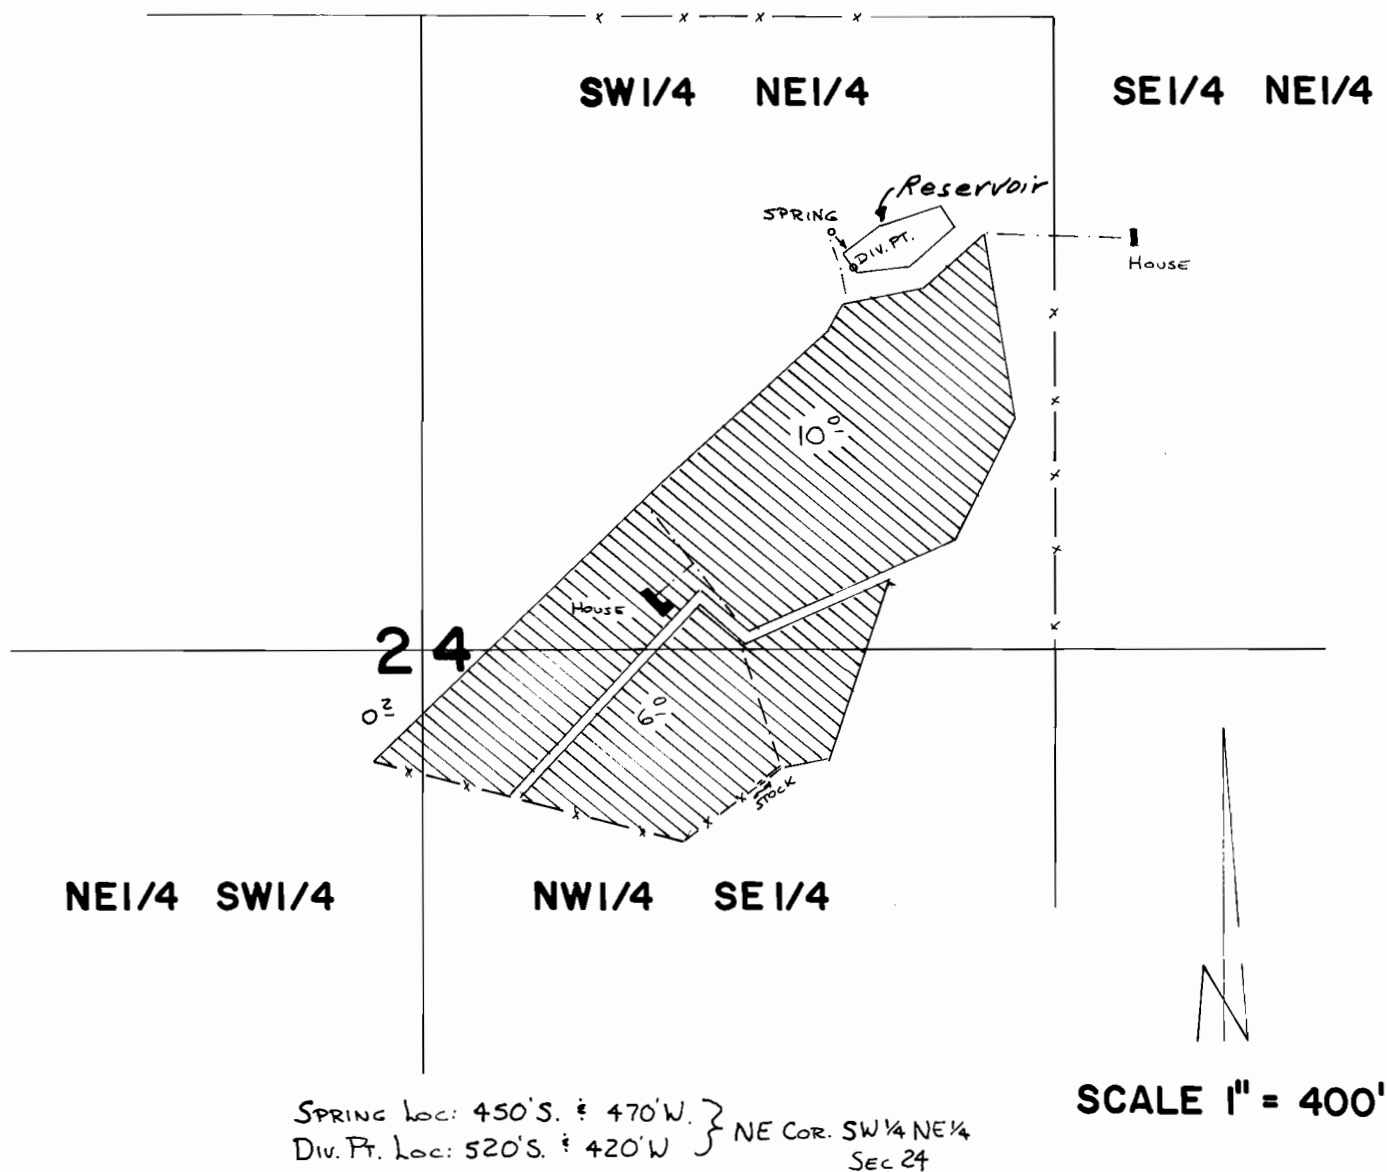

FINAL PROOF SURVEY UNDER

R-68092

R-10023

Application No. **68093** Permit No. **48872**
IN NAME OF

ROBERT F. McHANEY

Surveyed 4-27 1988, by V.L. Church