

T. 6 S., R. 41 E W M


14 13
23 24

N

UNNAMED SPR FED STREAM
LOCATED AB 114'S & 589' W
FROM NE COR SW 1/4 NE 1/4, SEC 24

DOMESTIC SPA LOCATED ABOUT
95'S & 589' W FROM NE COR
SW 1/4 NE 1/4, SEC 24

RESERVOIR LOCATED
ABOUT 150'S &
585' W FROM NE
COR, SW 1/4 NE 1/4,
SEC 24

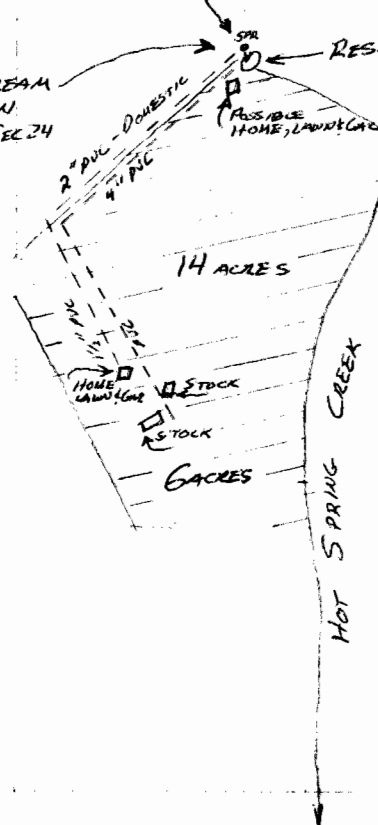

SCALE 8" = 1 MILE

APPLICATION 68093

Application No. R-68092

Permit No. R10023

18872

Robert E. McHoney