


T. 16 S., R. 10 W., W.M.

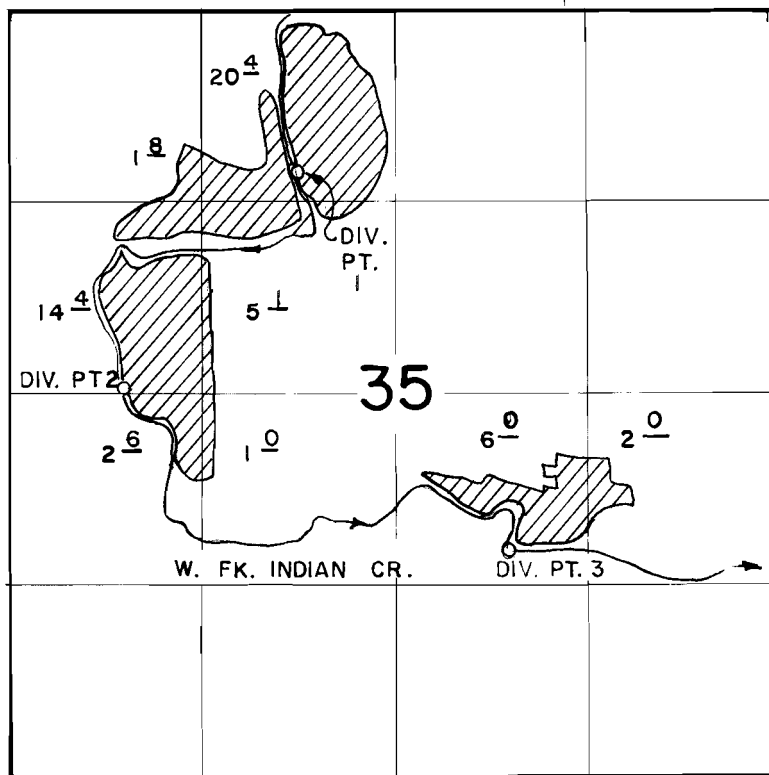

DIV. PTS. LOC.; 1 - 4160' N & 1970' E, 2 - 2670' N. & 780' E,
3 - 1550' N & 3440' E OF SW COR. SEC. 35

FINAL PROOF SURVEY UNDER

Application No. 44276 Permit No. 33072
IN NAME OF

UGO E. PEZZI

Surveyed JUN. 26 1984, by P. PAGTER