


T.17S., R.11W., W.M.

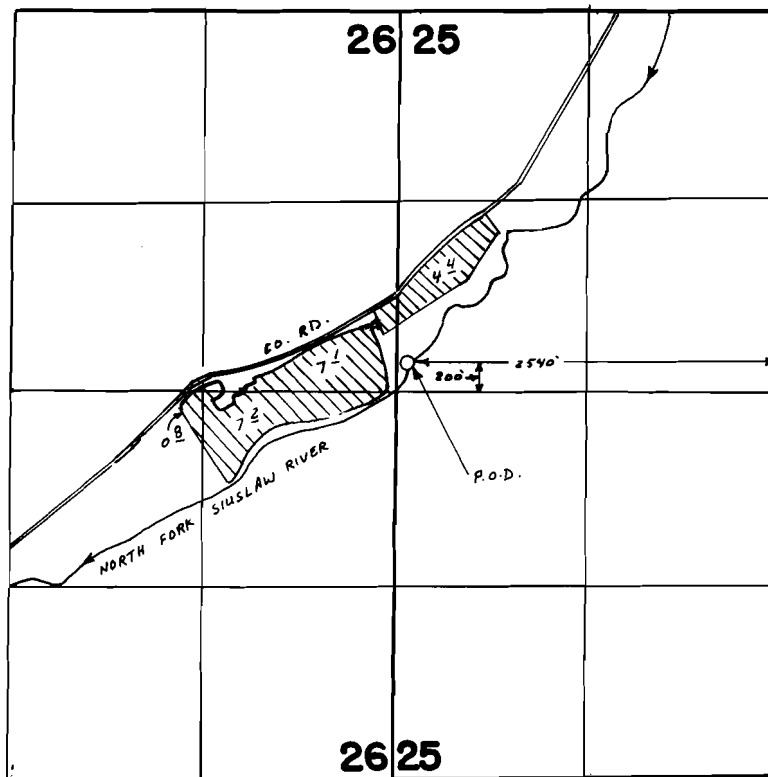

SCALE 1" = 1320'

FINAL PROOF SURVEY
UNDER

Application No. 54793 Permit No. 41110
IN NAME OF

EVERETT E. MILES, JR.

Surveyed AUG. 10, 1988, by ZEIDAN SALEH

41039-178-144 A
5-1-89 z.f.s.