


T. 13 S., R. 11 W., W.M.

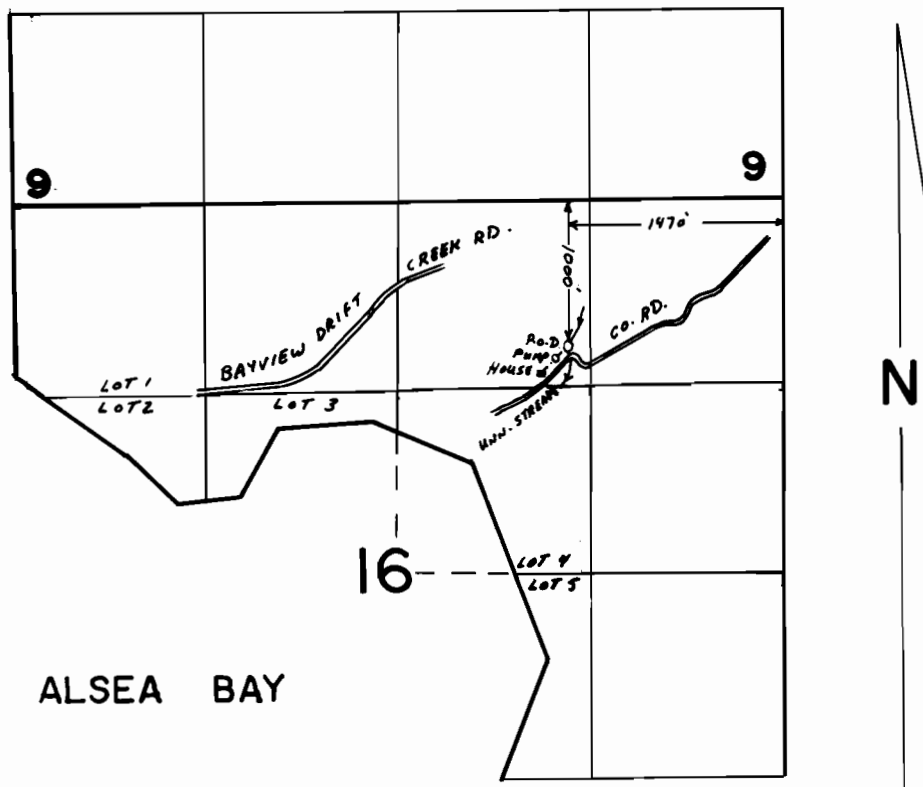

SCALE 1" = 1320'

FINAL PROOF SURVEY
UNDER

Application No. 56226... Permit No. 42178...

IN NAME OF

CHARLES W. HOCH

Surveyed JUL 27 1988, by Z. SALEH