


T.17S., R.1E., W.M.

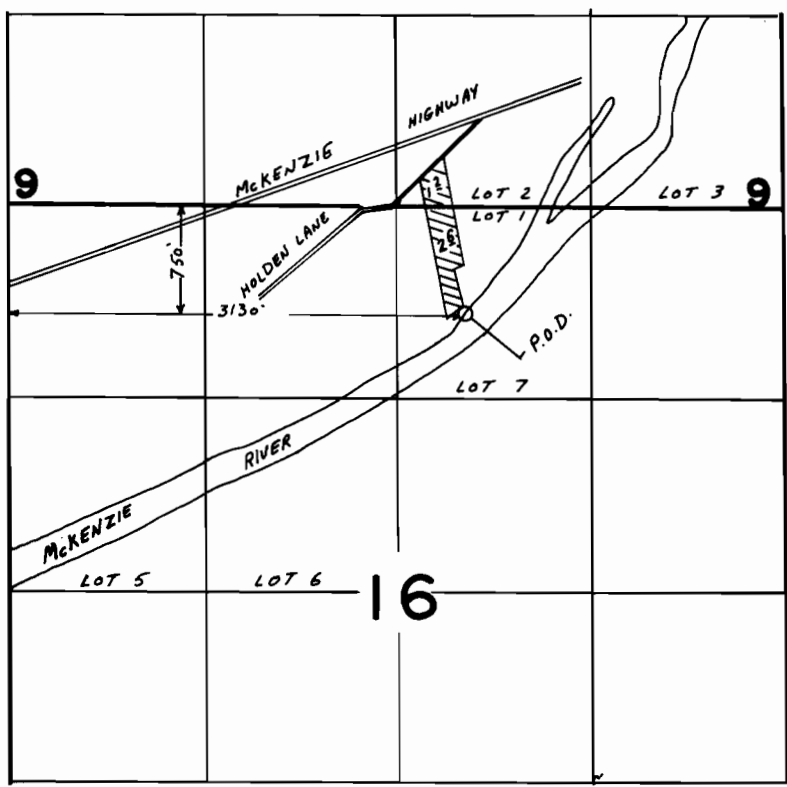

SCALE 1" = 1320'

FINAL PROOF SURVEY UNDER

Application No. **57848** Permit No. **43567**
IN NAME OF

THOMAS B. & FAYE SWANTON

Surveyed **MAY 26 88**, by **Z. SALEH**