


T. 11 S., R. 11 W., W. M.

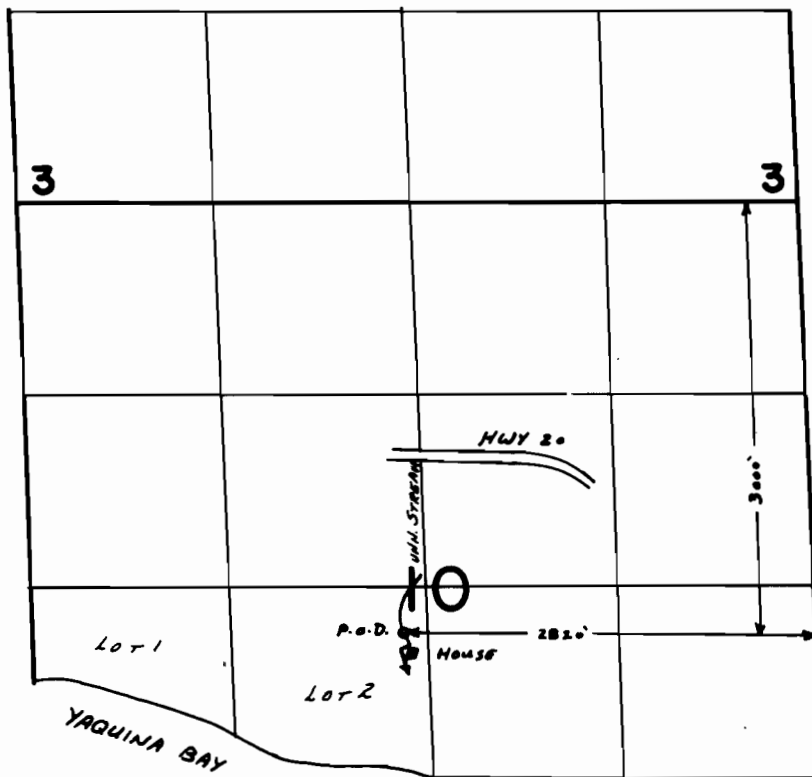

SCALE 1" = 1320'

FINAL PROOF SURVEY
UNDER

Application No. **57830** Permit No. **43699**
IN NAME OF

MICHAEL C. & DEENA R. SMITH

Surveyed **MAY 24 1988**, by **THOM WARREN**