


T.13S., R.10W., W.M.

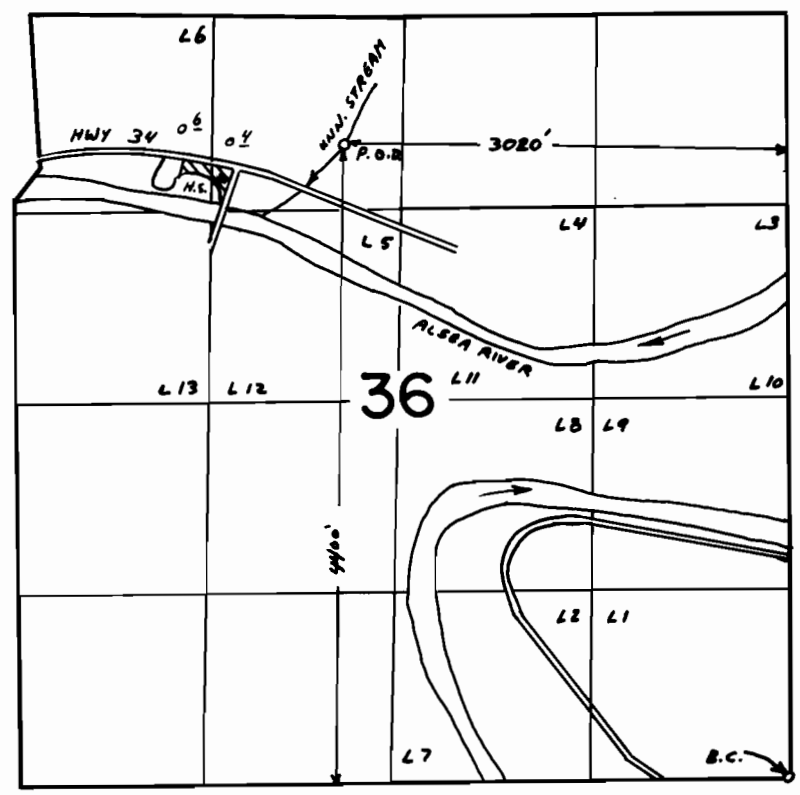

SCALE 1" = 1320'

FINAL PROOF SURVEY UNDER

Application No. 57917 Permit No. 43701
IN NAME OF

ANN ERICKSON

Surveyed JUL 26 88 by Z. SALEH
19....., by

41041-272-125
2-1-89 Z.F.S.