




# T.10S.,R.45E.,W.M.

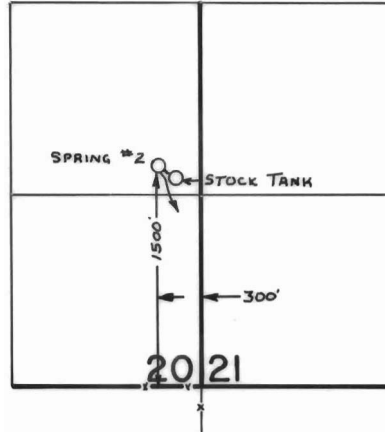

32

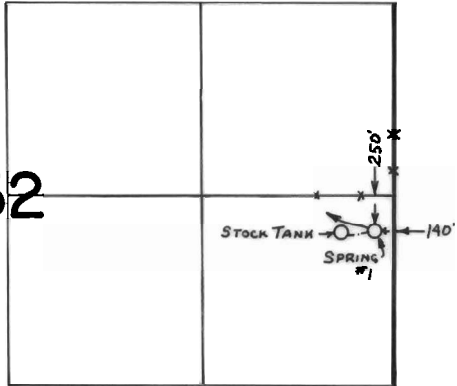

20 21

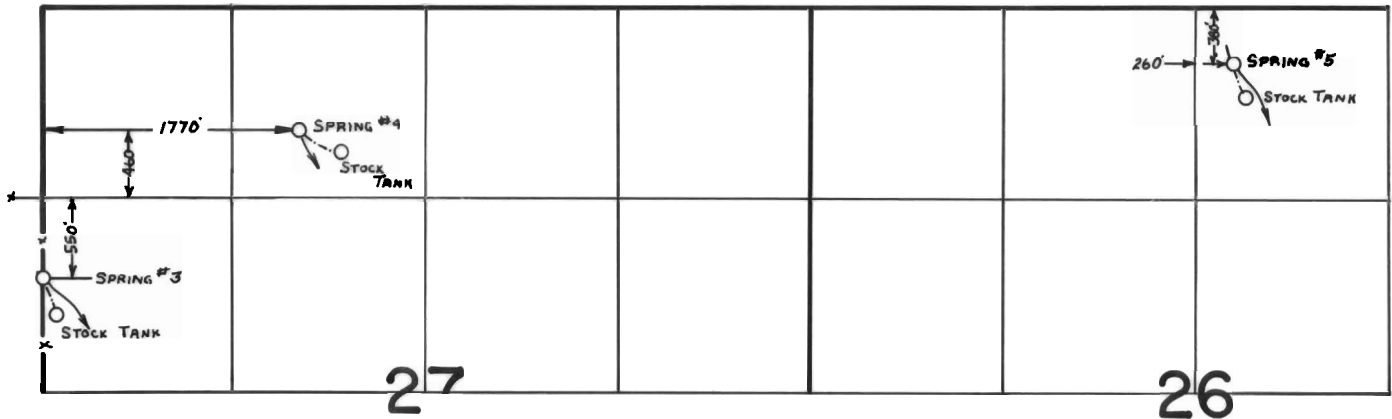

SCALE: 1" = 1320'

## FINAL PROOF SURVEY UNDER

Application No. 59433.. Permit No. 45653.....  
IN NAME OF

DONALD B. MARTIN

Surveyed Aug. 27.. 1985., by L. M. TOLL.....