


T.16S.,R.7W.,W.M.

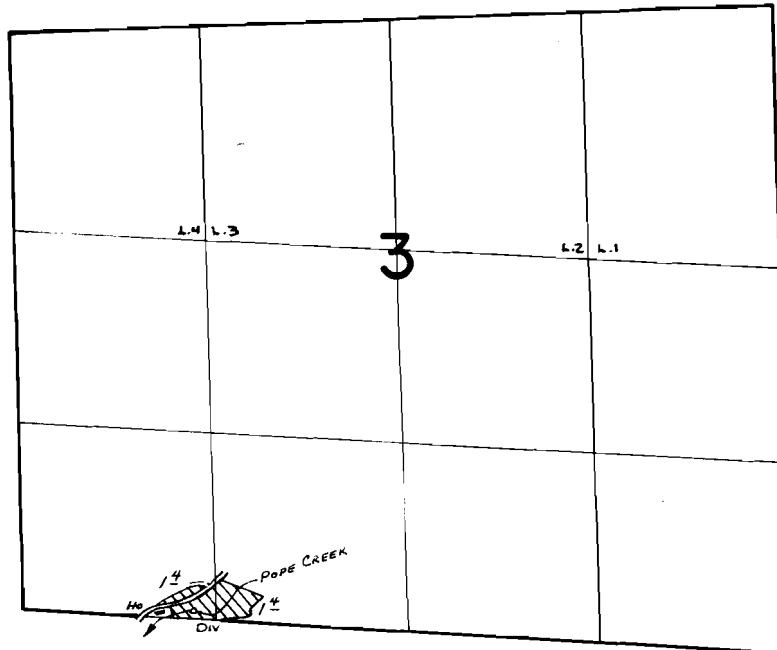

Div. Loc: 1160 ft E from SW Cor Sec 3

FINAL PROOF SURVEY
UNDER

Application No. 60481... Permit No. 45698.....
IN NAME OF

.....DON C. SANFORD.....

Surveyed Aug...4.... 19.82, by L.M.TOLL.....