


T.18 & 19 S., R.1 W., W.M.

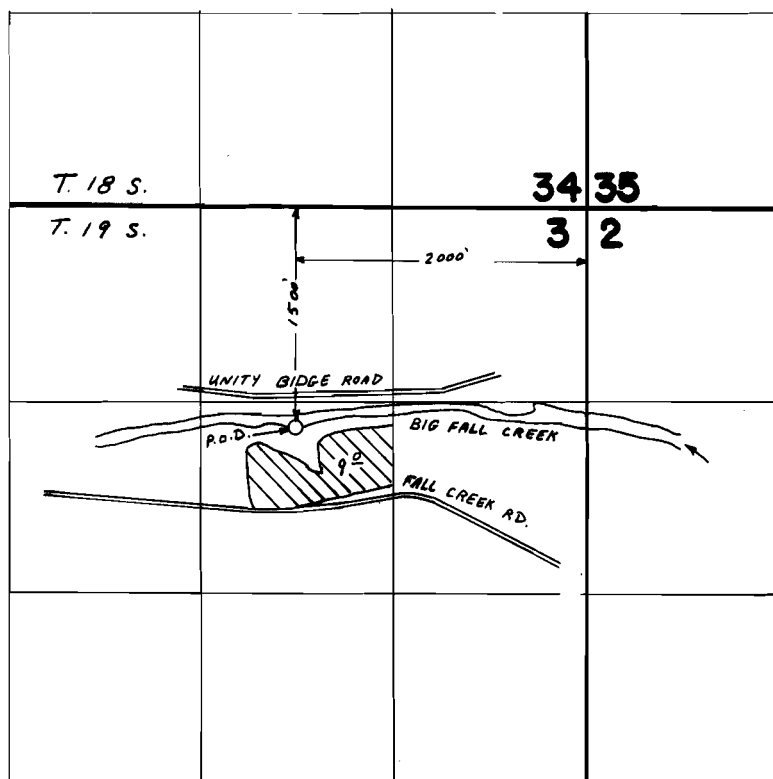

N

SCALE 1" = 1320'

FINAL PROOF SURVEY UNDER

Application No. 61595 Permit No. 45709
IN NAME OF

KEITH & JANE STANLEY

Surveyed MAY 23, 1988, by Z. SALEH

28Q-4JJ-94
5-9-89 Z.f.S.