
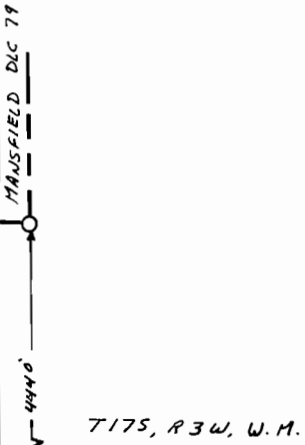


T. 16 S., R. 3 W., W. M.

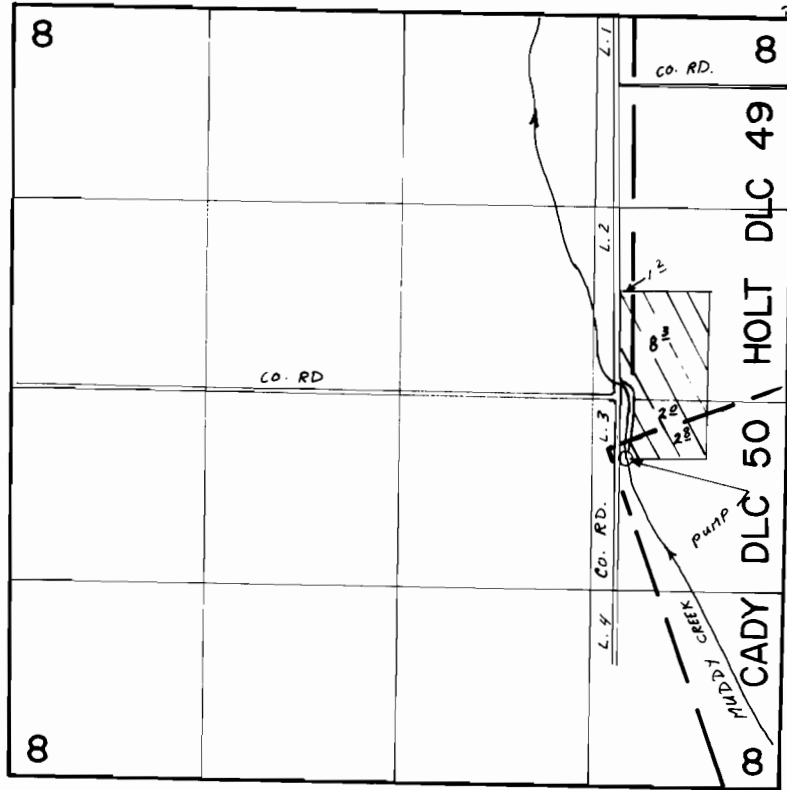

DLC 38

SCALE 1" = 1320'

FINAL PROOF SURVEY
UNDER

Application No. 5882.4 Permit No. 45832.....
IN NAME OF

MUDDY CREEKS IRRIGATION PROJECT

Surveyed MAY 23 1988, by Z. SALEH.....

41039-328-249A
5-10-89 Z. f. S.