


T. 9 S., R. 6 W., W.M.

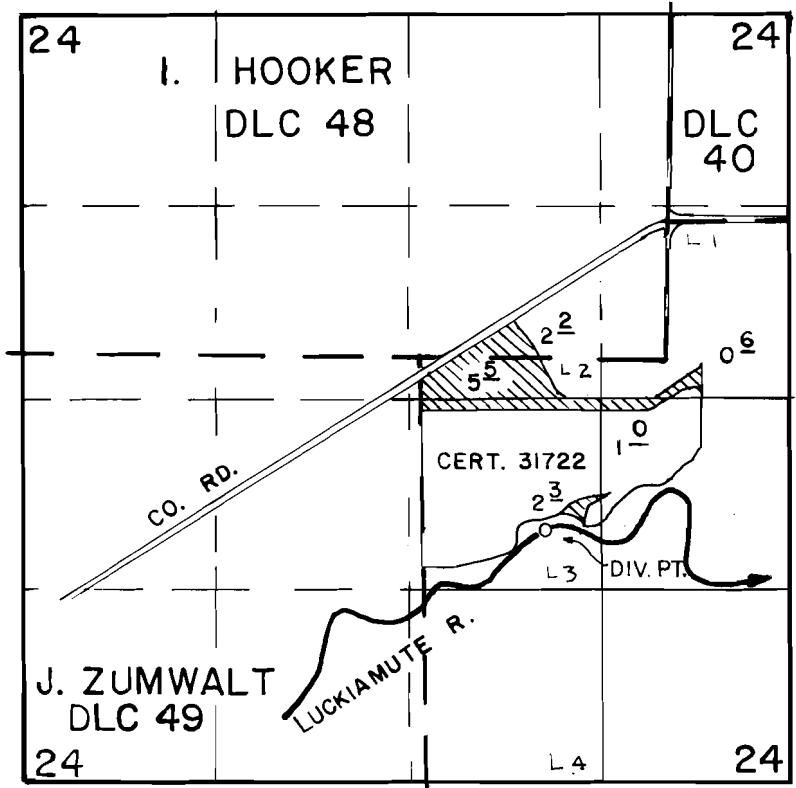

DIV. PT. LOC. 1160' S & 840' E OF NE COR. DLC 49



SCALE 1" = 1320'

FINAL PROOF SURVEY
UNDER

Application No. 60511 Permit No. 45906
IN NAME OF

FRANK B. DOLL

Surveyed AUG. 9, 1984, by L. TOLL